

CLARE COUNTY
REMONUMENTATION
APR 06 1995
COMMISSION

LAND CORNER RECORDATION CERTIFICATE
Filing Requirement of Act 74, Mich. P.A. 1970

RECEIVED
E 10 A 0
69-94
94 NOV 28 AM 10:36

REGISTER OF DEEDS
CLARE COUNTY
DONNA M. CARR

For corners in

CLARE
(County)

Located In:

Corner Code #

- | | | | | | |
|------------------------------------|---|-----|---|----|-----|
| 1. Public Land Survey | T | 18N | R | 5W | H-7 |
| | T | | R | | |
| | T | | R | | |
| | T | | R | | |
| 2. Property Controlling in Section | S | | T | R | |
| | S | | T | R | |
| 3. Miscellaneous Property in Sec. | S | | T | R | |
| | S | | T | R | |
4. Lot No. _____, Recorded Plat _____
5. Private Claims _____

Register of Deeds Stamp & File Number

I, MARK R. ROBISON, in a field survey on OCTOBER, 19 94, do hereby certify that under requirements of P.A. 74, Michigan P.A. of 1970, the corner points mentioned in lines 1 and 2 above were in conformance with regulations and rules therefore as required in the current manual of survey instructions of the United States Department of the Interior, Bureau of Land Management or by a decree of a Court of Law and/or that the corner points mentioned in lines 3, 4 and 5 above were in conformance with the rules of the Michigan Board of Land Surveyors or by a Decree of a Court of Law; established, re-established, monumented, re-monumented, recovered, found as expressed below:

	A	B	C	D	E	F	G	H	I	J	K	L	M
2	6	5	4	3	2	1							
3													
4	7	8	9	10	11	12							
5													
6	18	17	16	15	14	13							
7													
8	19	20	21	22	23	24							
9													
10	30	29	28	27	26	25							
11													
12	31	32	33	34	35	36							
13													

NOTE: Not more than 4 corners, all in the same town and range, may be recorded on this certificate.

- A. Description of original monument and accessories and/or subsequent restoration:
 1856, CANNON, POST (1)Y. PINE 16" N10°E 60 (2)W. PINE 14" SOUTH 20 G.L.O.
 NOV. 1913 (3)W. PINE 18" S45 1/2° E 74 LKS (4)W. PINE 16" S84 1/2°E C.S.R. 6-58
 10-3-77 LAPHAM, (5) OAK 16" EAST 23.15' (6)CHERRY 8" N80°E 34.07' (7)MAPLE 4" N25°E 36.40' (132) 2-318
 10-28-77 SEDGMAN, FD. 1/2" BAR R.L.S. CAPPED, SET CONC. MON. (5,6 & 7)-ABOVE, (8)WILD CHERRY 14" N60°W 21.53' (132) 2-299
 11-14-77 SEDGMAN, FOUND 1/2" BAR RLS CAPPED-RESET CONC. MON. (5,6,7 & 8)-ABOVE L.C.R.C. 304
 8-8-83 LAPHAM, FD. CONC. MON. (5,6,7 & 8)-ABOVE (132) 2-921
- B. Description of corner evidence found and/or method applied in restoring or reestablishing corner:
 FOUND CONC. MON. WITH FENCE POST ALONG SIDE- FOUND WITNESSES NOS. 5,6,7, & 8. SET NEW WITNESS.


APPROVED LAND CORNER
P.A. 345 of 1990
Clare County

Chairman Paul H. Lipp
Date Nov. 23, 1994

This Corner established in Clare County Remonumentation Program.

See dossier for detailed report.

- C. Description of monument for corner and accessories established to perpetuate locating the position of the corner:
 LEFT 4" DIA. CONC. MONUMENT WITH 1/2" IRON ROD FOR CLARE COUNTY REMONUMENTATION CORNER.
 WITNESSES:
 N60°, 34.03' - NAIL & TAG - 13" W. CHERRY (6)
 N30°E, 36.44' - NAIL & TAG - 10" MAPLE (7)
 N60°W, 21.53' - NAIL & TAG - 17" CHERRY (8)
 S20°W, 49.45' - NAIL & TAG - 10" CHERRY

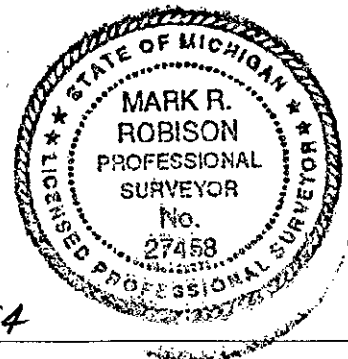

Signed by Mark R. Robison

Date 11-23-94

Surveyor's Michigan License No. 27458