

**SURVEY & REMONUMENTATION COMMISSION**  
**APR 06 1995**  
 For corners in CLARE  
 (County)

**LAND CORNER RECORDATION CERTIFICATE**  
 Filing Requirement of Act 74, Mich. P.A. 1970

RECEIVED  
 E  I  A   
 # 64-94  
 94 NOV 28 AM 10:36

REGISTER OF DEEDS  
 CLARE COUNTY  
 DONNA M. CARR

	Located In:	Corner Code #:
1. Public Land Survey	T 18N R 5W	I-7
	T _____ R _____	_____
	T _____ R _____	_____
	T _____ R _____	_____
2. Property Controlling in Section	S _____ T _____ R _____	_____
	S _____ T _____ R _____	_____
3. Miscellaneous Property in Sec.	S _____ T _____ R _____	_____
	S _____ T _____ R _____	_____
4. Lot No. _____, Recorded Plat _____		
5. Private Claims _____		

Register of Deeds Stamp & File Number

	A	B	C	D	E	F	G	H	I	J	K	L	M
2	6	5	4	3	2	1							
3													
4	7	8	9	10	11	12							
5													
6	18	17	16	15	14	13							
7													
8	19	20	21	22	23	24							
9													
10	30	29	28	27	26	25							
11													
12	31	32	33	34	35	36							
13													

I, MARK R. ROBISON, in a field survey on NOVEMBER, 19 94, do hereby certify that under requirements of P.A. 74, Michigan P.A. of 1970, the corner points mentioned in lines 1 and 2 above were in conformance with regulations and rules therefore as required in the current manual of survey instructions of the United States Department of the Interior, Bureau of Land Management or by a decree of a Court of Law and/or that the corner points mentioned in lines 3, 4 and 5 above were in conformance with the rules of the Michigan Board of Land Surveyors or by a Decree of a Court of Law; established, re-established, monumented, re-monumented, recovered, found as expressed below:

**NOTE: Not more than 4 corners, all in the same town and range, may be recorded on this certificate.**

- A. Description of original monument and accessories and/or subsequent restoration:
- NOV. 1856 CANNON, G.L.O. 12-11-56 W.S. MOORE, L.3-PG.54  
 POST (5)TRIPLE OAK S77°W 46.3'  
 WIT.-(1)W. PINE 16" S70°E 79 LKS. (6)W. OAK 8" S46°E 38.4'  
 (2)W. PINE 30" N32°W 6 LKS.
  - 10-20-04 A. JOHNSON C.S.R. L.4-PG.46 3-19-75 MEYERS, (132) L.2-PG.39  
 WIT.-(1)ABOVE FOUND 3/4" ROD  
 (3)W. PINE 30" S12°W 67 LKS. (7)POWER POLE EAST 53.37'  
 (8)MAPLE 20" N30°E 87.00'  
 (9)OAK 18" S70°W 52.79'
  - 11-02-04 A. JOHNSON, C.S.R. L.1-PG.34 8-20-75 LAPHAM, L.C.R.C. #209  
 WIT.-(1) & (3) ABOVE 3/4" ROD  
 WIT.-(1) & (3) ABOVE WIT.-(7), (8) & (9) ABOVE
  - 11-26-13 C.S.R. L.6-PG.50 8-8-83 LAPHAM, (132) L.2-PG.920  
 WIT.-(1) & (3) ABOVE, FOUND 3/4" BAR  
 (4)W. PINE 30" N62°E 102 LKS. WIT.-(7) (8) & (9) ABOVE


- 9-15-76 SEDGMAN, (132) L.2-PG.175  
 FOUND 3/4" ROD  
 WIT.-(7), (8), & (9) ABOVE
- 10-28-77 SEDGMAN, (132) L.2-PG.299  
 FOUND 3/4" BAR  
 WIT.-(7), (8), & (9) ABOVE
- 11-3-80 LAPHAM, (132) L.2-PG.732  
 FOUND 3/4" ROD  
 WIT.-(7), (8) & (9) ABOVE
- 8-8-83 LAPHAM, (132) L.2-PG.920  
 FOUND 3/4" BAR  
 WIT.-(7) (8) & (9) ABOVE

- B. Description of corner evidence found and/or method applied in restoring or reestablishing corner:
- FOUND 3/4"x18" ROD. EXCAVATED TO 3 FEET, FOUND OLD ROAD BED AT 2 FEET. FOUND NO OTHER EVIDENCE.  
 FOUND WITNESSES #7 (NAIL), #8 (NAIL IN STUMP), #9 (NAIL & TAG)

APPROVED LAND CORNER  
 P.A. 345 of 1990  
 Clare County  
 Chairman Paul B. Leph  
 Date Nov. 23, 1994

This Corner established in Clare County Remonumentation Program.  
 See dossier for detailed report.

- C. Description of monument for corner and accessories established to perpetuate locating the position of the corner:
- SET 5/8" X 36" RE-ROD WITH 3" CLARE COUNTY MONUMENT CAP IN MONUMENT BOX.  
 WITNESSES:  
 EAST 53.37' - NAIL & TAG IN POWER POLE (7)  
 N30°E 87.00' - NAIL & TAG IN 24" MAPLE STUMP (8)  
 S70°W 52.79' - NAIL & TAG IN 24" OAK (9)  
 N45°W 89.0' - NAIL & TAG IN 4" SCOTCH PINE  
 WEST 1.7' @ ASPHALT PAVEMENT

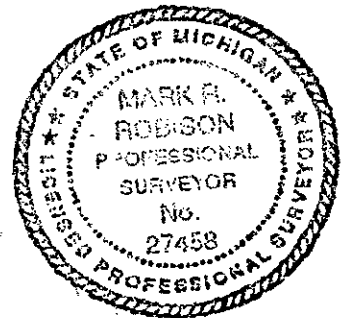

Signed by Mark R. Robison Date 11-23-94  
 Surveyor's Michigan License No. 27458