

NOV 18 1997

CLARE COUNTY REMONUMENTATION

COMMISSION LAND CORNER RECORDATION CERTIFICATE
Filing Requirement of Act 74, Mich. P.A. 1970

RECEIVED

224-97
97 OCT 15 AM 10:53

REGISTER OF DEEDS
CLARE COUNTY
CAROL A. McAULAY
GREENWOOD
LINCOLN

Register of Deeds Stamp & File Number

corners in

LARE _____ Located In: _____ Corner Code # _____
(County)

Public Land Survey T19N R5W K-13
T18N R5W K-1
T _____ R _____
T _____ R _____
T _____ R _____

Property Controlling S _____ T _____ R _____
In Section S _____ T _____ R _____
Miscellaneous S _____ T _____ R _____
Property in Sec. S _____ T _____ R _____

Lot No. _____, Recorded Plat _____
Private Claims _____

MARK R. ROBISON, in a field survey on July 1, 1997 do hereby state that under requirements of P.A. 74, Michigan P.A. of 1970, the corner points mentioned in lines 1 and 2 above were in conformance with regulations and rules therefore as required in the current manual of survey instructions of the United States Department of the Interior, Bureau of Land Management or by a decree of a Court of Law and/or that the corner points mentioned in lines 3, 4 and 5 above were in conformance with the rules of the Michigan Board of Land Surveyors or by a Decree of a Court of Law, established, re-established, monumented, discovered, found as expressed below:

NOTE: Not more than 2 corners, all in the same town and range, may be recorded on this certificate.

| | | | | | | | | | | | | | |
|----|---|----|---|----|---|----|---|----|---|----|---|----|---|
| 1 | A | B | C | D | E | F | G | H | I | J | K | L | M |
| 2 | | 6 | 5 | | 4 | | 3 | | 2 | | 1 | | |
| 3 | | | | | | | | | | | | | |
| 4 | | 7 | | 8 | | 9 | | 10 | | 11 | | 12 | |
| 5 | | | | | | | | | | | | | |
| 6 | | 18 | | 17 | | 16 | | 15 | | 14 | | 13 | |
| 7 | | | | | | | | | | | | | |
| 8 | | 19 | | 20 | | 21 | | 22 | | 23 | | 24 | |
| 9 | | | | | | | | | | | | | |
| 10 | | 30 | | 29 | | 28 | | 27 | | 26 | | 25 | |
| 11 | | | | | | | | | | | | | |
| 12 | | 31 | | 32 | | 33 | | 34 | | 35 | | 36 | |
| 13 | | | | | | | | | | | | | |

- A. Description of original monument and accessories and/or subsequent restoration:
- 1838 Nicholson
Set Post Cor. Sec's 35 & 36
Wit.-W. Pine 50 N77E 20
W. Pine 22 N87W 21
 - 1856 Cannon-G.L.O. Resurvey
Wit.-W. Oak 12" S39E 43
W. Pine 30" S15W 67
 - 6-29-12 Johnson C.S.R. 2-16 & 6-37
Wit.-W. Pine Stmp. 50" N71E 20
W. Pine Stmp. 22" N77W 21
Meas. 39.60 to East
 - 04-02-74 Lapham (132) 1-715
Found 1" Pipe
Wit.-N30W 83.7 14" Oak
East 71.65 Triple 14" Oak
S25W 67.9 24" Oak
 - 7-19-74 Lapham L.C.R.C.# 153
Wit.-same as (132) 1-715

- 2-27-80 Sedgman (132) 2-574 & 2-575
Found 1" Pipe
Wit.-West 28.82 P.P.
N35W 84.08 16" Trip. Oak
N85E 34.77 18" Oak
S70E 54.12 18" Trip. Oak
- 4-28-80 Sedgman (132) 2-579
Reference Corner
- 7-30-80 Sedgman L.C.R.C.# 376
Wit.-same as (132) 2-574

- B. Description of corner evidence found and/or method applied in restoring or reestablishing corner:
- Found all 1974 and 1980 witnesses. Excavated at corner. Found 18" sucker rod, 12" x 5" x 1/2" metal plate, 6" x 1" x 1/4" bar, pieces of old clay tile, and stones around corner.

See dossier for detailed report.


APPROVED LAND CORNER
P.A. 345 of 1990
Clare County

Chairman Paul H. [Signature]
Date 9-23-97

- C. Description of monument for corner and accessories established to perpetuate locating the position of the corner:

K-13: Corner common to Sections 35 & 36, T19N, R5W, AND Sections 1 & 2, T18N, R5W (K-1). Set 5/8" x 36" rered with 3" Clare County Monument Cap marked P.S.#27458. Accepted as best available evidence of perpetuation of C.S.R. Corner.

- Witnesses:
- N30W 83.70', set N&T, 21" Oak (OBT)
 - S70E 54.12', set N&T, 20" Tr. Oak (OBT)
 - East 71.65', set N&T, 20" Trip. Oak (OBT)
 - S25W 67.90', set N&T, 44" Oak (OBT)
 - West 28.82', set N&T, P.P. (OBT)

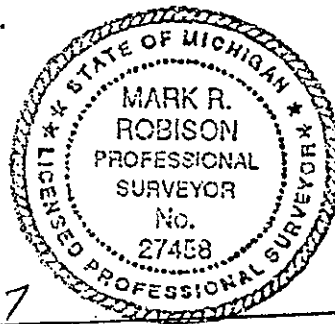

Signed by [Signature]
Surveyor's Michigan License No. 27458

Date 10-01-97