

REMON

NOV 1 1997

COMMISSION

CLARE COUNTY REMONUMENTATION

LAND CORNER RECORDATION CERTIFICATE

Filing Requirement of Act 74, Mich. P.A. 1970

RECEIVED
226-97
97 OCT 15 AM 10:53

REGISTER OF DEEDS
CLARE COUNTY
CAROL A. McAULAY

GREENWOOD
HAYES
LINCOLN
HATTON

Register of Deeds Stamp & File Number

For corners in

CLARE
(County)

Located In:	Corner Code #
T 19N R 5W	M-13
T 19N R 4W	A-13
T 18N R 5W	M-1
T 18N R 4W	A-1
S _____ T _____ R _____	_____
S _____ T _____ R _____	_____
S _____ T _____ R _____	_____
S _____ T _____ R _____	_____

1. Public Land Survey

2. Property Controlling in Section

3. Miscellaneous Property in Sec.

4. Lot No. _____ Recorded Plat _____

5. Private Claims _____

I, MARK R. ROBISON, in a field survey on July 1, 19 97 do hereby state that under requirements of P.A. 74, Michigan P.A. of 1970, the corner points mentioned in lines 1 and 2 above were in conformance with regulations and rules therefore as required in the current manual of survey instructions of the United States Department of the Interior, Bureau of Land Management or by a decree of a Court of Law and /or that the corner points mentioned in lines 3, 4 and 5 above were in conformance with the rules of the Michigan Board of Land Surveyors or by a Decree of a Court of Law; established, re-established, monumented, recovered, found as expressed below:

NOTE: Not more than 2 corners, all in the same town and range, may be recorded on this certificate.

- A. Description of original monument and accessories and/or subsequent restoration:
- 1838 Nicholson
Set Post Cor of T18 & 19N, R4 & 5W.
Wit-Pine 26" S82W 40
Pine 28" S84E 61
 - 6-29-12 Johnson C.S.R. 2-16 & 6-37
Tile for Sec. Cor.
Wit-F. Post 8" S35W 18
M-13 to L-13, 40.20
 - 9-14-12 Johnson C.S.R. 2-21
Corner is tile
M-13 to K-13 81.60
 - 9-21-12 Johnson C.S.R. 2-22
Cor is tile
A-13 to B-13 (Hayes) 43.32
 - Undated C.S.R. 6-247
A-13 to B-13 (Hayes) 43.04

	A	B	C	D	E	F	G	H	I	J	K	L	M
1													
2	6		5		4		3		2		1		
3													
4	7		8		9		10		11		12		
5													
6	18		17		16		15		14		13		
7													
8	19		20		21		22		23		24		
9													
10	30		29		28		27		26		25		
11													
12	31		32		33		34		35		36		
13													

11-29-89 Lapham L.C.R.C.# 594
Found 1/2" rerod in Fence Cor.
Wit-N50E 56.1 4" W. Oak
N20E 49.3 15" Oak
S70E 31.6 6" Maple
S40E 51.1 4" Maple


B. Description of corner evidence found and/or method applied in restoring or reestablishing corner:
Found clay tile 1.5 feet South of capped iron per L.C.R.C.#594. Tile is 0.6 ft. SE of 10" Fence Post Corner for fences North, South, East, & West. Found three 1989 witnesses that fit capped iron. Accepted tile as Corner.

APPROVED LAND CORNER
P.A. 345 of 1990
Clare County
Chairman Paul A. Lepko
Date 9-23-97

See dossier for detailed report.

C. Description of monument for corner and accessories established to perpetuate locating the position of the corner:
M-13: Corner common to Section 36, T19N, R5W, (M-13); Section 1, T18N, R5W, (M-1); Section 31, T19N, R4W, (A-13); and Section 6, T18N, R4W, (A-1). Set 5/8" x 36" rerod with 3" Clare County Monument Cap marked P.S.#27458. Accepted as best available evidence of perpetuation of C.S.R. Corner.

- Witnesses:
- S22E 49.4', N&T, 6" & 8" Twin Maple
 - S26E 51.15', N&T, 18" Red Oak
 - N73W 9.30', N&T, 20" Maple

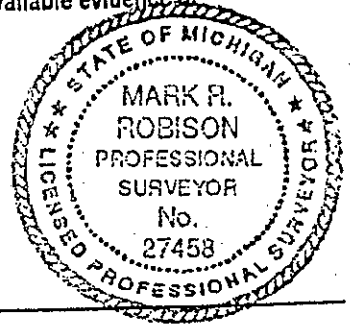

Signed by Mark R. Robison
Surveyor's Michigan License No. 27458

Date 10-01-97