SURVEY & MAPPING COMMISSION

DEC 1 1995

COMMISSION

RECEIVED
ENTERED
101-95
95 OCT -3 PM 2:49
REGISTER OF DEEDS
CLARE COUNTY
DONNA M CARR

LAND CORNER RECORDATION CERTIFICATE

Filing Requirement of Act 74, Mich. P.A. 1970

For corners in CLARE (County)

	Located In:	Corner Code #
1. Public Land Survey	T 19N R 5W	A-7
	T ___ R ___	
	T ___ R ___	
	T ___ R ___	
2. Property Controlling	S ___ T ___ R ___	
in Section	S ___ T ___ R ___	
3. Miscellaneous	S ___ T ___ R ___	
Property in Section	S ___ T ___ R ___	

Register of Deeds Stamp & File Number

4. Lot No. _____, Recorded Plat _____
5. Private Claims _____

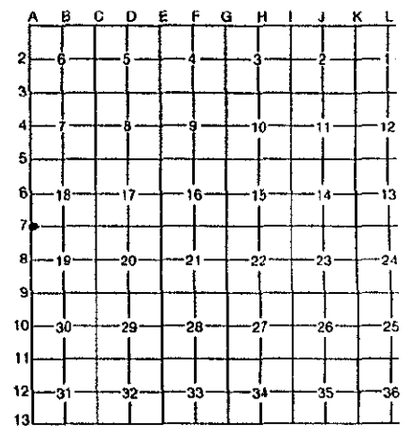

I, MARK R. ROBISON, in a field survey on SEPTEMBER, 19 95, do hereby certify that under requirements of P.A. 74, Michigan P.A. of 1970, the corner points mentioned in lines 1 and 2 above were in conformance with regulations and rules therefore as required in the current manual of survey instructions of the United States Department of the Interior, Bureau of Land Management or by a decree of a Court of Law and/or that the corner points mentioned in lines 3, 4 and 5 above were in conformance with the rules of the Michigan Board of Professional Surveyors or by a Decree of a Court of Law; established, re-established, monumented, re-monumented, recovered, found as expressed below:

NOTE: Not more than 4 corners, all in the same town and range, may be recorded on this certificate.

A. Description of original monument and accessories and/or subsequent restoration:

A-7: 18-19 SEC. CORNER ON TWP. LINE

1838 NICHOLSON, HEMLOCK 14 N52E 36, W. PINE 18 S45E 65

UNDATED NO SURVEYOR IDENTIFIED, PINE 16 N63-30E 147, PINE 16 S48E 144, CSR

MDOT NO WITNESSES, CORNER FALLS 2.06 SOUTH OF TANGENT, MEASURES 2646.02 TO A-6
MEASURES 2570.65 TO A-8

B. Description of corner evidence found and/or method applied in restoring or reestablishing corner:

FOUND 1" IRON IN MON BOX. CORNER FALLS 1.55 NORTH OF CONSTRUCTED CENTER-LINE OF M-61.
COULD NOT REMOVE IRON

MEASURES EAST 4938.90 FEET TO C-7 (GLO 4959.90)
MEASURES WEST 2605.52 FEET TO L-7, T19N, R6W

APPROVED LAND CORNER
P.A. 345 of 1990
Clare County
Chairman Paul A. Lyle
Date 9-26-95

This Corner established in Clare County Remonumentation Program.

See dossier for detailed report.

C. Description of monument for corner and accessories established to perpetuate locating the position of the corner:

A-7: 18-19 SEC. CORNER ON TWP. LINE
ACCEPTED 1" IRON AS CLARE COUNTY REMONUMENTATION MONUMENT.
ACCEPTED AS BEST AVAILABLE EVIDENCE OF THE ACCEPTED POSITION OF THE CORNER.

WITNESSES:
N62°W 193.08' - NAIL & TAG IN POWER POLE
N18°W 102.24' - NAIL & TAG IN LEFT GATE POST
N13°E 80.41' - NAIL & TAG IN 3RD FENCE POST FROM RIGHT GATE POST
S48°W 172.08' - NAIL & TAG IN 7" ELM

STATE OF MICHIGAN
MARK R. ROBISON
PROFESSIONAL SURVEYOR
No. 27458
LICENSED PROFESSIONAL SURVEYOR

Signed by Mark R Robison Date 10-03-95

Surveyor's Michigan License No. 27458

FORM APPROVED BY MICHIGAN STATE BOARD OF PROFESSIONAL SURVEYORS, JAN. 28, 1971
REVISED MAY 14, 1975
REVISED JAN., 1983