

REMONUMENTATION

NOV 1 1997

COMMISSION

CLARE COUNTY REMONUMENTATION

LAND CORNER RECORDATION CERTIFICATE  
Filing Requirement of Act 74, Mich. P.A. 1970

RECEIVED

# 206-97  
97 OCT 15 AM 10:50

REGISTER OF DEEDS  
CLARE COUNTY  
CAROL A. McCAULAY

SUMMERFIELD  
GREENWOOD

Register of Deeds Stamp & File Number

For corners in

CLARE  
(County)

Located In:

Corner Code #

1. Public Land Survey	T20N R5W	B-13
	T19N R5W	B-1
	T R	
	T R	
2. Property Controlling in Section	S T R	
	S T R	
3. Miscellaneous Property in Sec.	S T R	
	S T R	

4. Lot No. \_\_\_\_\_, Recorded Plat \_\_\_\_\_  
5. Private Claims \_\_\_\_\_

I, MARK R. ROBISON, in a field survey on July 1, 1997 do hereby state that under requirements of P.A. 74, Michigan P.A. of 1970, the corner points mentioned in lines 1 and 2 above were in conformance with regulations and rules therefore as required in the current manual of survey instructions of the United States Department of the Interior, Bureau of Land Management or by a decree of a Court of Law and for that the corner points mentioned in lines 3, 4 and 5 above were in conformance with the rules of the Michigan Board of Land Surveyors or by a Decree of a Court of Law; established, re-established, monumented, recovered, found as expressed below.

NOTE: Not more than 2 corners, all in the same town and range, may be recorded on this certificate.

A	B	C	D	E	F	G	H	I	J	K	L	M
1												
2	6		5		4		3		2		1	
3												
4	7		8		9		10		11		12	
5												
6	18		17		16		15		14		13	
7												
8	19		20		21		22		23		24	
9												
10	30		29		28		27		26		25	
11												
12	31		32		33		34		35		36	
13												

A. Description of original monument and accessories and/or subsequent restoration:  
1838 Nicholson Set 1/4 Sec Post Wit.-P. Pine 18" N56W 30 W. Pine 26" N89 1/2E 43  
8-10-92 Roser LCRC#702 Fd Pipe by M. Schaaf 1941. Schaaf set Pipe from W. Pine Stp. remains NE with "Portions of lower face plainly visible" that he says was G.L.O. Added D.N.R. Mon & set Ced. Post Wit.-2" W. Pine N15W 9.6' 2" W. Pine N35E 28.7' 3" W. Pine S75E 11.8' 10" B. Oak S60W 20.3'

B. Description of corner evidence found and/or method applied in restoring or reestablishing corner:  
Found D.N.R. Monument and witnesses and remains of GLO 26" Pine stump.


See dossier for detailed report.

APPROVED LAND CORNER  
P.A. 345 of 1990  
Clare County

Chairman Paul B. Poph  
Date 9-23-97

C. Description of monument for corner and accessories established to perpetuate locating the position of the corner:  
Accepted D.N.R. Monument as Clare County Remonumentation Monument. Accepted as perpetuation of original corner.

Witnesses:  
N15W 9.60', N&T, 3" W. Pine (OBT)  
N35E 28.70', N&T, 3" W. Pine (OBT)  
S75E 11.80', N&T, 4" W. Pine (OBT)  
S60W 20.30', N&T, 12" B. Oak (OBT)

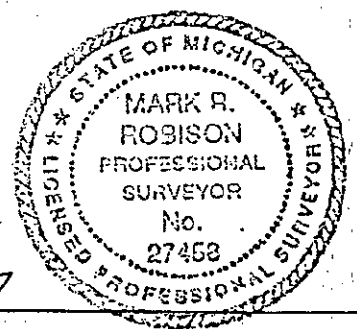

Signed by Mark R. Robison  
Surveyor's Michigan License No. 27458

Date 10-01-97