REMONUMENTATION

NOV 1 8 1997

COMMISSION

CLARE COUNTY REMONUMENTATION

LAND CORNER RECORDATION CERTIFICATE
Filing Requirement of Act 74, Mich. P.A. 1970

RECEIVED
#207-97
97 OCT 15 AM 10:50
REGISTER OF DEEDS
CLARE COUNTY
CAROL A. McAULAY
SUMMERFIELD
GREENWOOD

Register of Deeds Stamp & File Number

For corners in

CLARE (County)

	Located In:		Corner Code #
1. Public Land Survey		T20N R5W	C-13
		T19N R5W	C-1
		T___ R___	
		T___ R___	
2. Property Controlling in Section	S___	T___ R___	
	S___	T___ R___	
3. Miscellaneous Property in Sec.	S___	T___ R___	
	S___	T___ R___	

4. Lot No. _____ , Recorded Plat _____
5. Private Claims _____

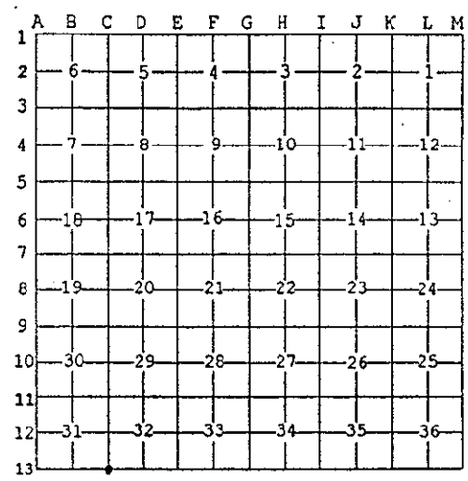

I, MARK R. ROBISON, in a field survey on July 1, 19 97 do hereby state that under requirements of P.A. 74, Michigan P.A. of 1970, the corner points mentioned in lines 1 and 2 above were in conformance with regulations and rules therefore as required in the current manual of survey instructions of the United States Department of the Interior, Bureau of Land Management or by a decree of a Court of Law and /or that the corner points mentioned in lines 3, 4 and 5 above were in conformance with the rules of the Michigan Board of Land Surveyors or by a Decree of a Court of Law; established, re-established, monumented, recovered, found as expressed below:

NOTE: Not more than 2 corners, all in the same town and range, may be recorded on this certificate.

A. Description of original monument and accessories and/or subsequent restoration:

1838 Nicholson
Set Post Cor Sec.'s 31 & 32
Wit.- P. Pine 15" N17E 08
P. Pine 7" N68W 05

8-10-92 Roser LCRC#702
Restored SW Cor of Sec 32 from (4) M. Schaaf (RLS & Dept Forestry Chief) 1941 NBT's; (3 stp. remains and one live B. Oak) Schaaf notes indicate he had orig evidence here. Ctr. N-S sand road is 40' +/- E. Set D.N.R. Mon and Ced. Post. Fd 1/2" rerod w/RLS cap "J.S.#18664" N78-51E 62.74'.
Wit.-20" B. Oak North 16.7 (OBT)
3" Tw. B. Oak S75E 5.1
7" B. Oak S30W 25.0'
2" W. Pine S70W 44.5'

B. Description of corner evidence found and/or method applied in restoring or reestablishing corner:

Found D.N.R. Monument and witnesses. Found remains of GLO 15" Pine.

See dossier for detailed report.

APPROVED LAND CORNER
P.A. 345 of 1990
Clare County
Chairman Paul B. Fogle
Date 9-23-97

C. Description of monument for corner and accessories established to perpetuate locating the position of the corner:

Accepted D.N.R. Monument as Clare County Remonumentation Monument. Accepted as perpetuation of original corner.

Witnesses:
North 16.70', N&T, 22" B. Oak (OBT)
S75E 5.10', N&T, 5" Twin B. Oak (OBT)
S30W 25.00', N&T, 8" B. Oak (OBT)
S70W 44.50', N&T, 3" W. Pine

STATE OF MICHIGAN
MARK R. ROBISON
PROFESSIONAL SURVEYOR
No. 27458
LICENSED PROFESSIONAL SURVEYOR

Signed by Mark R. Robison Date 10-01-97

Surveyor's Michigan License No. 27458

FORM APPROVED BY MICHIGAN STATE BOARD OF PROFESSIONAL SURVEYORS, JAN. 28, 1971
REVISED MAY 14, 1975
REVISED JAN., 1983
REVISED OCT., 1995