

DEC 01 1995

LAND CORNER RECORDATION CERTIFICATE  
Filing Requirement of Act 74, Mich. P.A. 1970

RECEIVED  
E. J. LEAD  
# 103-95

REGISTER OF DEEDS  
CLARE COUNTY  
DONNA M. CARR

COMMISSION  
For corners in  
CLARE  
(County)

Located in:

Corner Code #

- 1. Public Land Survey T 19N R 5W C-7  
T \_\_\_\_\_ R \_\_\_\_\_  
T \_\_\_\_\_ R \_\_\_\_\_  
T \_\_\_\_\_ R \_\_\_\_\_
- 2. Property Controlling S \_\_\_\_\_ T \_\_\_\_\_ R \_\_\_\_\_  
in Section S \_\_\_\_\_ T \_\_\_\_\_ R \_\_\_\_\_
- 3. Miscellaneous S \_\_\_\_\_ T \_\_\_\_\_ R \_\_\_\_\_  
Property in Section S \_\_\_\_\_ T \_\_\_\_\_ R \_\_\_\_\_

Register of Deeds Stamp & File Number

- 4. Lot No. \_\_\_\_\_, Recorded Plat \_\_\_\_\_
- 5. Private Claims \_\_\_\_\_

A	B	C	D	E	F	G	H	I	J	K
2	6	5	4	3	2					
3										
4	7	8	9	10	11					
5										
6	18	17	16	15	14					
7										
8	19	20	21	22	23					
9										
10	30	29	28	27	26					
11										
12	31	32	33	34	35					
13										

I, MARK R. ROBISON, in a field survey on SEPTEMBER, 19 95, do hereby certify that under requirements of P.A. 74, Michigan P.A. of 1970, the corner points mentioned in lines 1 and 2 above were in conformance with regulations and rules therefore as required in the current manual of survey instructions of the United States Department of the Interior, Bureau of Land Management or by a decree of a Court of Law and/or that the corner points mentioned in lines 3, 4 and 5 above were in conformance with the rules of the Michigan Board of Professional Surveyors or by a Decree of a Court of Law; established, re-established, monumented, re-monumented, recovered, found as expressed below:

NOTE: Not more than 4 corners, all in the same town and range, may be recorded on this certificate.

A. Description of original monument and accessories and/or subsequent restoration:

C-7: Corner common to Sections 17, 18, 19 & 20

1856 ADAIR, POST, B. ASH 9 N70E 30, HEMLOCK 8 S40 1/2W 16

8-84 LAPHAM, SAME AS 9-80 (132) SURVEY

MDOT FOUND 1" IRON ROD  
WIT.-N47°W 49.65' FENCE CORNER  
N42°E 45.18' TELE. POLE  
S40°W 56.60' FENCE CORNER

10-85 LAPHAM, FOUND 1" IRON IN MON. BOX (132) SURVEY  
SAME WITNESSES AS MDOT  
SOUTH 13.66' & M-61

9-80 WILCOX, FOUND 1" PIPE IN MON. BOX, L.C.R.C.  
WIT.-N44°E 65.00' POWER POLE  
N28°W 41.90' SIGN POST  
S15°E 71.20' SIGN POST WEST  
S27°W 87.38' POWER POLE

B. Description of corner evidence found and/or method applied in restoring or reestablishing corner:

FOUND 1" PIPE IN MON. BOX 13.26 NORTH OF & M-61 FOUND WITNESSES OF 9-80 L.C.R.C. MEAS. WEST 2628.66 TO B-7 AND EAST 2630.55 TO D-7. COULD NOT REMOVE PIPE.

APPROVED LAND CORNER  
P.A. 345 of 1990  
Clare County

Chairman Paul S. Taylor

Date \_\_\_\_\_

This Corner established in Clare County Remonumentation Program.


See dossier for detailed report.

C. Description of monument for corner and accessories established to perpetuate locating the position of the corner:

C-7: Corner common to Sections 17, 18, 19 & 20

SET 1/2"x12" RE-ROD WITH CLARE COUNTY REMONUMENTATION CAP MARKED 1995, P.S. # 27458 IN EXISTING 1" PIPE. ACCEPTED AS BEST AVAILABLE EVIDENCE OF THE ACCEPTED POSITION OF THE CORNER.

WITNESSES:  
N44°E 65.00' - NAIL & TAG IN POWER POLE (OBT)  
N32°W 42.62' - NAIL & TAG IN SIGN POST  
S17°E 71.60' - NAIL & TAG IN SIGN POST (OBT)  
S9E 189.83' - NAIL & TAG IN POWER POLE  
S27°W 87.38' - NAIL & TAG IN POWER POLE (OBT)  
SOUTH 13.26' - & M-61

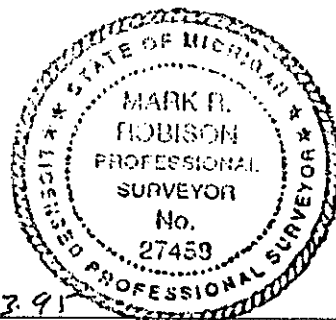

Signed by Mark R. Robison

Date 10-03-95

Surveyor's Michigan License No. 27458