

DEC 1 1995

LAND CORNER RECORDATION CERTIFICATE
Filing Requirement of Act 74, Mich. P.A. 1970

RECEIVED
E 10 A D
#104-95
95 OCT -3 PM 2:49

For corners in COMMISSION
CLARE
(County)

Located In:

Corner Code #

- 1. Public Land Survey T 19N R 5W D-7
 T R
 T R
 T R
- 2. Property Controlling S T R
 in Section S T R
- 3. Miscellaneous S T R
 Property in Section S T R

Register of Deeds Stamp & File Number

- 4. Lot No. _____, Recorded Plat _____
- 5. Private Claims _____

A	B	C	D	E	F	G	H	I	J	K	L
2	6	5	4	3	2						
3											
4	7	8	9	10	11	12					
5											
6	18	17	16	15	14	13					
7											
8	19	20	21	22	23	24					
9											
10	30	29	28	27	26	25					
11											
12	31	32	33	34	35	36					
13											

I, MARK R. ROBISON, in a field survey on SEPTEMBER, 19 95, do hereby certify that under requirements of P.A. 74, Michigan P.A. of 1970, the corner points mentioned in lines 1 and 2 above were in conformance with regulations and rules therefore as required in the current manual of survey instructions of the United States Department of the Interior, Bureau of Land Management or by a decree of a Court of Law and/or that the corner points mentioned in lines 3, 4 and 5 above were in conformance with the rules of the Michigan Board of Professional Surveyors or by a Decree of a Court of Law; established, re-established, monumented, re-monumented, recovered, found as expressed below:

NOTE: Not more than 4 corners, all in the same town and range, may be recorded on this certificate.

A. Description of original monument and accessories and/or subsequent restoration:
D-7: 1/4 CORNER COMMON TO SECTIONS 17 & 20
1856 ADAIR, BEECH 4 N31E 8, BEECH 6 S64W 12
MDOT WITNESSES: N40W 51.85' GAS LINE MARKER
 N15W 33.38' T. POLE
 S30E 40.48' GAS LINE MARKER


B. Description of corner evidence found and/or method applied in restoring or reestablishing corner:
FOUND 1" PIPE IN MON. BOX 11.59' NORTH OF C M-61
CONSTRUCTION HAS DESTROYED MDOT WITNESSES.
MEASURED WEST 2630.55 FEET TO C-7 & EAST 2630.60' TO E-7 COULD NOT REMOVE PIPE.

APPROVED LAND CORNER
P.A. 345 of 1990
Clare County
Chairman Paul S. Tapp
Date 10-26-95

This Corner established in Clare County Remonumentation Program.
See dossier for detailed report.

C. Description of monument for corner and accessories established to perpetuate locating the position of the corner:
D-7: 1/4 CORNER COMMON TO SECTIONS 17 & 20
Set 1/2"x6" re-rod with Clare County Remonumentation cap. marked 1995 PS 27458 in existing 1" pipe. poured concrete around pipe & base of monument.
Accepted as best available evidence of the accepted position of the corner.

WITNESSES:
N40°W 95.60' - MARKER FOR GAS LINE
N14°E 64.06' - H-WAY R/W MARKER (CONC.)
S16°E 143.62' - NAIL & TAG IN 5" JACK PINE
S3°W 123.45' - NAIL & TAG IN 9" JACK PINE

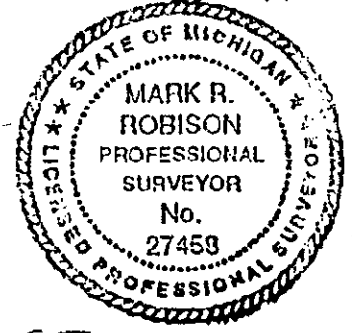

Signed by Mark R. Robison Date 10-03-95
Surveyor's Michigan License No. 27458