

**SURVEY &
REMONUMENTATION**

JAN 23 2001

LAND CORNER RECORDATION CERTIFICATE

SECTION

Filing Requirement of Act 74, Mich. P.A. 1970

Clare County Remonumentation 20000010170

Filed for Record in
CLARE COUNTY MICHIGAN
CAROL MCAULAY
On 12-15-2000 At 07:44 am.
LAND CORNER 9.00
OR Liber 2 Page 293 - 293

For Corners in
Clare

(County)

Located In:

Corner Code#:

- 1. Public Land Survey T. 19N R. 5W I-11
T. _____ R. _____
T. _____ R. _____
- 2. Public Controlling S. _____ T. _____ R. _____
in Section S. _____ T. _____ R. _____
- 3. Miscellaneous S. _____ T. _____ R. _____
Property in Section S. _____ T. _____ R. _____
- 4. Lot No. _____, Recorded Plat _____
- 5. Private Claims _____

Instrument Liber Page
200000010170 OR 2 293

498-00

Register of Deeds Stamp & File Number

I, Mark R. Robison, in a field survey on May 9, 2000, do hereby certify that under requirements of P.A. 74, Michigan P.A. of 1970, the corner points mentioned in lines 1 and 2 above were in conformance with regulations and rules therefore as required in the current manual of survey instructions of the United States Department of the Interior, Bureau of Land Management or by a decree of a Court of Law and/or that the corner points mentioned in lines 3, 4 and 5 above were in conformance with the rules of the Michigan Board of Land Surveyors or by a Decree of a Court of Law, established, re-established, monumented, re-monumented, recovered, found as expressed below.

	A	B	C	D	E	F	G	H	I	J	K	L	M
1													
2	6	5	4	3	2	1							
3													
4	7	8	9	10	11	12							
5													
6	18	17	16	15	14	13							
7													
8	19	20	21	22	23	24							
9													
10	30	29	28	27	26	25							
11													
12	31	32	33	34	35	36							
13													

NOTE: Not more than 2 corners, all in the same town and range, may be recorded on this certificate.

A. Description of original monument and accessories and/or subsequent restoration:

GLO, Adair, 1857
W. Pine 14" N34°W, 54 LINKS
W. Pine 20" S57 1/2°E, 19 LINKS

Survey, Lapham, 1976, revised 1981, L2. Pg. 120 & 673
Same as survey L2. Pg. 539
I-11 to J-11 = 2640.70

McClung, 1976, LCRC #287-77
1" pipe, 2 witnesses

Plat, Greenwood Forest, Meyers, 1966, L8. Pg. 18
H-11 to I-11 = 2603.10

Survey, Meyers, 1977, L2. Pg. 539
3/4" Pipe, 3 witnesses, 2 same as LCRC #287-77

APPROVED LAND CORNER
P.A. 345 of 1990
Clare County

Survey, Dyer, 1981, L1. Pg. 631 to 640
1 1/2" bar, 4 witnesses, 3 same as survey L2. Pg. 539
I-11 to J-11 = 2640.42

Chairman Paul S. Sopher
Date 12-13-00

B. Description of corner evidence found and/or method applied in restoring or re-establishing corner.


No GLO evidence found. Found capped iron in monument box in E-W centerline and 37 feet East of centerline to North. Both witnesses from LCRC #287-77 were still in place, one was a monument from the Plat of Greenwood Forest. The found iron is as platted in Greenwood Forest. Accepted found iron as best available evidence of accepted position of corner.

C. Description of monument for corner and accessories established to perpetuate locating the position of the corner:

Set 5/8" x 36" rered with Clare County Remon Cap marked P.S. #27458 in Mon. Box.

Witnesses:

- North, 33.00' - Concrete monument (OBT)
- N60°W, 69.0' - N & T in Power Pole
- S63°W, 69.8' - N & T in Power Pole
- South, 33.00' - Concrete monument (OBT)

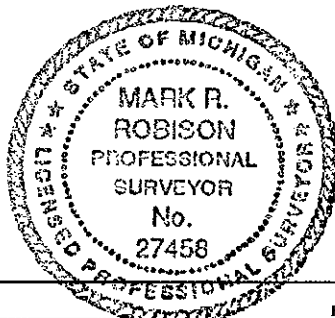

Signed by Mark R. Robison
Surveyor's Michigan License No. 27458

Date 12/14/2000