

NOV 18 1997

CLARE COUNTY REMONUMENTATION

COMMISSION

LAND CORNER RECORDATION CERTIFICATE
Filing Requirement of Act 74, Mich. P.A. 1970

RECEIVED

#222-97
97 OCT 15 AM 10:52

REGISTER OF DEEDS
CLARE COUNTY
CAROL A. McAULAY

GREENWOOD
LINCOLN

Register of Deeds Stamp & File Number

For corners in

CLARE

(County)

Located In:

Corner Code #

1. Public Land Survey

T19N R5W

I-13

T18N R5W

I-1

T R

T R

2. Property Controlling
in Section

S T R

S T R

3. Miscellaneous
Property in Sec.

S T R

S T R

4. Lot No. _____, Recorded Plat _____

5. Private Claims _____

I, MARK R. ROBISON, in a field survey on July 1, 1997 do hereby state that under requirements of P.A. 74, Michigan P.A. of 1970, the corner points mentioned in lines 1 and 2 above were in conformance with regulations and rules therefore as required in the current manual of survey instructions of the United States Department of the Interior, Bureau of Land Management or by a decree of a Court of Law and/or that the corner points mentioned in lines 3, 4 and 5 above were in conformance with the rules of the Michigan Board of Land Surveyors or by a Decree of a Court of Law; established, re-established, monumented, recovered, found as expressed below:

NOTE: Not more than 2 corners, all in the same town and range, may be recorded on this certificate.

	A	B	C	D	E	F	G	H	I	J	K	L	M
1													
2	6		5		4		3		2		1		
3													
4	7		8		9		10		11		12		
5													
6	18		17		16		15		14		13		
7													
8	19		20		21		22		23		24		
9													
10	30		29		28		27		26		25		
11													
12	31		32		33		34		35		36		
13													

A. Description of original monument and accessories and/or subsequent restoration:

1838 Nicholson
Set Post Cor. Sec. 34 & 35
Wit-Aspen 8 N10E 07
Birch 8 N78W 18

1-08-76 Lapham (132) 2-120 & 2-673
Revised 3-29-76 & 8-25-81
Found wood hub--set capped rerod
Wit.-East 3.40 6" Cedar
West 9.60 14" Birch
S20E 12.70 8" Cedar

11-09-83 Ostling L.C.R.C.# 456
Found Conc. Mon. as established in
previous survey of Section 3
Wit.-N40E 32.4 8" R. Oak
S22E 42.2 5" R. Oak
South 33.0 3/4" Rod

6-27-12 Johnson C.S.R. 2-17 & 6-38
Wit-Tamarac 12" N45E 9
Cedar 8" S45E 6
I-1 to K-1 80.38

1-18-78 Meyers (132) 2-539
Wit.-same as (132) 2-120

B. Description of corner evidence found and/or method applied in restoring or reestablishing corner:

Found concrete monument per L.C.R.C.# 456. Found three 1976 witnesses. 1983 witnesses are not there and appear to be for a different corner. Fences North, South, and East.

APPROVED LAND CORNER
P.A. 345 of 1990
Clare County


See dossier for detailed report.

Chairman Paul A. Lapham
Date 9-23-97

C. Description of monument for corner and accessories established to perpetuate locating the position of the corner:

I-13: Corner common to Sections 34 & 35, T19N,R5W, AND Sections 2 & 3, T18N, R5W, (I-1). Pulled concrete monument and set 5/8" x 36" rerod with 3" Clare County Monument Cap marked P.S.#27458. Accepted as best available evidence of accepted position of corner.

Witnesses:
East 3.40', N&T, 8" Cedar (OBT)
West 9.60', nail & tag, 18" Birch (OBT)
S30E 12.70', nail & tag, 12" Cedar (OBT)
S59W 21.50', N&T, 20" W. Pine

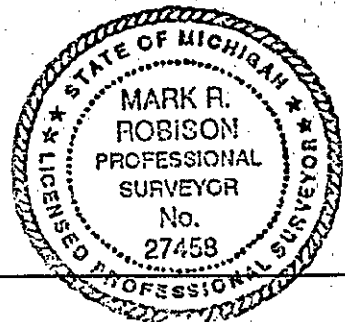

Signed by Mark R. Robison
Surveyor's Michigan License No. 27458

Date 10-01-97