

NOV 18 1997

CLARE COUNTY REMONUMENTATION

COMMISSION

LAND CORNER RECORDATION CERTIFICATE
Filing Requirement of Act 74, Mich. P.A. 1970

RECEIVED
#214-97
97 OCT 15 AM 10:50
REGISTER OF DEEDS
CLARE COUNTY
CAROL A. McAULAY
SUMMERFIELD
GREENWOOD

For corners in

CLARE (County)	Located In:	Corner Code #
1. Public Land Survey	T20N R 5W T19N R 5W T____ R____ T____ R____	J-13 J-1
2. Property Controlling in Section	S____ T____ R____ S____ T____ R____	_____ _____
3. Miscellaneous Property in Sec.	S____ T____ R____ S____ T____ R____	_____ _____

Register of Deeds Stamp & File Number

4. Lot No. _____, Recorded Plat _____
5. Private Claims _____

I, MARK R. ROBISON, in a field survey on July 1, 1997 do hereby state that under requirements of P.A. 74, Michigan P.A. of 1970, the corner points mentioned in lines 1 and 2 above were in conformance with regulations and rules therefore as required in the current manual of survey instructions of the United States Department of the Interior, Bureau of Land Management or by a decree of a Court of Law and/or that the corner points mentioned in lines 3, 4 and 5 above were in conformance with the rules of the Michigan Board of Land Surveyors or by a Decree of a Court of Law; established, re-established, monumented, recovered, found as expressed below:

NOTE: Not more than 2 corners, all in the same town and range, may be recorded on this certificate.

	A	B	C	D	E	F	G	H	I	J	K	L	M
1													
2	6		5		4		3		2		1		
3													
4	7		8		9		10		11		12		
5													
6	10		17		16		15		14		13		
7													
8	19		20		21		22		23		24		
9													
10	30		29		28		27		26		25		
11													
12	31		32		33		34		35		36		
13													

A. Description of original monument and accessories and/or subsequent restoration:

1838 Nicholson Set 1/4 Sec Post Wit-Beech 10" N30E 13 Beech 18" N57W 30	8-10-92 Roser LCRC#707 Fd old 1 1/4" pipe for S 1/4 Cor Sec 35 Old Fn. Cor 28' South. Old fence N and new Fn N&W 28' N. Drove 1/2" x 32" rerod in old pipe. Wit-N75E 101.62 18" W. Pine S30E 40.28 10" R. Pine S30W 38.70 4" Scotch Pine North 28.46 Cor. Fn. Post South 28.36 Old Cor Fn. Post
1-6-77 Lapham LCRC#271 Fd 2" Pipe in C/L Rd & Fence N&S Wit-North 28.53 Fence Cor South 27.8 Fence Cor S20E 38.40 4" Pine	

3-22-96 Schripsema (132) 3-532
References J-13 as SE Cor of survey
Set Iron 33' North

B. Description of corner evidence found and/or method applied in restoring or reestablishing corner:
Found 1/2" x 32" rerod in 1 1/4" x 36" pipe. Excavated and found no other material. Found 1977 and 1992 witnesses.

See dossier for detailed report.


APPROVED LAND CORNER
P.A. 345 of 1990
Clare County

Chairman Paul R. Leph
Date 9-23-97

C. Description of monument for corner and accessories established to perpetuate locating the position of the corner:

Set 5/8" x 36" rerod with Clare County Remonumentation Cap marked P.S.#27458. Accepted as best available evidence of the accepted position of the corner.

Witnesses:
South 27.74', N&T, new F. Post
North 28.36', N&T, Cor. F. Post (OBT)
N75E 101.62', N&T, 24" W. Pine (OBT)
S30E 40.28', N&T, 13" R. Pine (OBT)

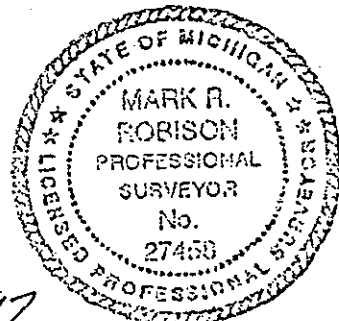

Signed by Mark R. Robison
Surveyor's Michigan License No. 27458

Date 10-01-97