

DEC 1 1995

FILING REQUIREMENT OF ACT 74, MICH. P.A. 1970

RECEIVED
E 113 2 LI
#111-95
95 OCT -3 PM 2:50

For corners in CLARE
(County)

Located In:

Corner Code #

1. Public Land Survey	T	<u>19N</u>	R	<u>5W</u>	<u>K-7</u>
	T		R		
	T		R		
	T		R		
2. Property Controlling in Section	S		T	R	
	S		T	R	
3. Miscellaneous Property in Section	S		T	R	
	S		T	R	

REGISTER OF DEEDS
CLARE COUNTY
DONNA M. CARR

Register of Deeds Stamp & File Number

4. Lot No. _____, Recorded Plat _____
5. Private Claims _____

A	B	C	D	E	F	G	H	I	J	K	L	A
2	6		5		4		3		2		1	
3												
4	7		8		9		10		11		12	
5												
6	18		17		16		15		14		13	
7												
8	19		20		21		22		23		24	
9												
10	30		29		28		27		26		25	
11												
12	31		32		33		34		35		36	
13												

I, MARK R. ROBISON, in a field survey on SEPTEMBER, 19 95, do hereby certify that under requirements of P.A. 74, Michigan P.A. of 1970, the corner points mentioned in lines 1 and 2 above were in conformance with regulations and rules therefore as required in the current manual of survey instructions of the United States Department of the Interior, Bureau of Land Management or by a decree of a Court of Law and/or that the corner points mentioned in lines 3, 4 and 5 above were in conformance with the rules of the Michigan Board of Professional Surveyors or by a Decree of a Court of Law; established, re-established, monumented, re-monumented, recovered, found as expressed below:

NOTE: Not more than 4 corners, all in the same town and range, may be recorded on this certificate.

A. Description of original monument and accessories and/or subsequent restoration:

- K-7: Corner common to Sections 13, 14, 23 & 24
1856 ADAIR, BEECH 8 N30W 26, HEMLOCK 10 S17E 15
MDOT, 1 1/4" PIPE
WITNESSES: N33E 56.10' TELE. POLE
S40E 46.56' SIGN POST
S43W 45.45' FENCE CORNER
- 7-68 LAPHAM, REF. CORNER 2646.09' NORTH OF K-8 SURVEY
- 6-71 COURTRIGHT, SAME WITNESSES AS MDOT (132) SURVEY
- 6-71 COURTRIGHT, FOUND 5/8" ROD, SAME WIT. AS MDOT L.C.R.C.
- 1-72 MCCLUNG, MON. BOX 2 WIT. SAME AS MDOT L.C.R.C.
- 7-72 URBANIAK, SAME WIT. AS MDOT (132) SURVEY
- 7-72 LAPHAM, SAME WIT. AS MDOT (132) SURVEY
- 10-72 LAPHAM, SAME WIT. AS MDOT (132) SURVEY
- 5-76 SEDGMAN, FOUND BAR IN MON. BOX (132) SURVEY
WITNESSES: S30W 53.39' FENCE POST
N60W 100.30' 8" PINE
N45E 56.18' TELE. POLE
- 8-76 SEDGMAN, SAME AS 5-76 L.C.R.C.

B. Description of corner evidence found and/or method applied in restoring or reestablishing corner:

FOUND 1/2" IRON IN MON. BOX AT INTERSECTION OF CENTER-LINE. FOUND ONE MDOT WITNESS & TWO SEDGMAN WITNESSES. MEASURED WEST 2624.75' TO J-7 AND EAST 2638.25' (MDOT 2638.27', SEDGMAN 2637.46') TO L-7. MDOT SHOWS 2645.87' TO K-8. (7-68 SURVEY SHOWS 2646.09')

APPROVED LAND CORNER
P.A. 345 of 1990
Clare County


Chairman Paul S. Apple
Date 9-26-95

This Corner established in Clare County Remonumentation Program.

See dossier for detailed report.

C. Description of monument for corner and accessories established to perpetuate locating the position of the corner:

- K-7: Corner common to Sections 13, 14, 23 & 24
SET 3" CLARE COUNTY MONUMENT CAP MARKED 1995 P.S. #27458 ON EXISTING 1/2" RE-ROD IN MONUMENT BOX.
ACCEPTED AS BEST AVAILABLE EVIDENCE OF THE ACCEPTED POSITION OF THE CORNER.
- WITNESSES:
N45E 56.18' - NAIL & TAG IN TELE. POLE STUB (MDOT)
N60W 100.30' - NAIL & TAG IN 12" RED PINE (OBT)
S39E 86.0' - NAIL & TAG IN 14" WILLOW
S31W 195.06' - NAIL & TAG IN POWER POLE

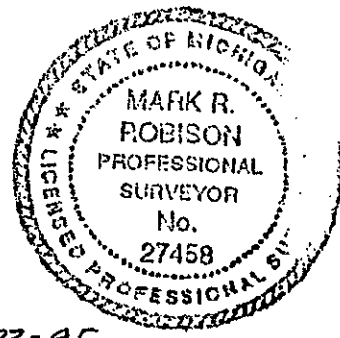

Signed by Mark R. Robison
Surveyor's Michigan License No. 27458

Date 10-03-95