

LAND CORNER RECORDATION CERTIFICATE
Filing Requirement of Act 74, Mich. P.A. 1970

For corners in

<u>CLARE</u> (County)	Located In:	Corner Code #
1. Public Land Survey	T <u>19N</u> R <u>5W</u>	<u>K-8</u>
	T <u> </u> R <u> </u>	<u> </u>
	T <u> </u> R <u> </u>	<u> </u>
	T <u> </u> R <u> </u>	<u> </u>
2. Property Controlling in Section	S <u> </u> T <u> </u> R <u> </u>	<u> </u>
	S <u> </u> T <u> </u> R <u> </u>	<u> </u>
3. Miscellaneous Property in Sec.	S <u> </u> T <u> </u> R <u> </u>	<u> </u>
	S <u> </u> T <u> </u> R <u> </u>	<u> </u>

REGISTER OF DEEDS
 CLARE COUNTY
 DONNA M. GARR
 #145-96
 96 NOV 14 PM 4:14
 Register of Deeds Stamp & File Number

4. Lot No. _____, Recorded Plat _____
 5. Private Claims _____

I, MARK R. ROBISON, in a field survey on AUGUST, 1996 do hereby state that under requirements of P.A. 74, Michigan P.A. of 1970, the corner points mentioned in lines 1 and 2 above were in conformance with regulations and rules therefore as required in the current manual of survey instructions of the United States Department of the Interior, Bureau of Land Management or by a decree of a Court of Law and/or that the corner points mentioned in lines 3, 4 and 5 above were in conformance with the rules of the Michigan Board of Land Surveyors or by a Decree of a Court of Law; established, re-established, monumented, recovered, found as expressed below:

NOTE: Not more than 2 corners, all in the same town and range, may be recorded on this certificate.

A	B	C	D	E	F	G	H	I	J	K	L	M
1												
2	6		5		4		3		2		1	
3												
4	7		8		9		10		11		12	
5												
6	18		17		16		15		14		13	
7												
8	19		20		21		22		23		24	
9												
10	30		29		28		27		26		25	
11												
12	31		32		33		34		35		36	
13												

- A. Description of original monument and accessories and/or subsequent restoration:
- 1857 ADAIR
WIT.-W. PINE 14" N69°E 64 LKS.
B. OAK, 18" S16°W 39 LKS.
 - 1-28-71 McCLUNG, (132) L.1, PG. 163.
WIT.- FOUND W. 1/4 COR.
 - 1-31-72 McCLUNG, L.C.R.C. #36
WIT.-IRON ROD
N52°E, 37.70' - NAIL IN 10" B. OAK.
S67°W, 35.62' - NAIL IN 14" W. OAK.
 - 7-20-72 URBANIAK, (132) L.1, PG. 279
WIT.-N34°E, 58.81' - 10" POPLAR.
N68°E, 44.33' - 17" TWIN OAK.
S67°W, 35.53' - 14" OAK.
 - 9-25-72 URBANIAK, (132) L.1, PG. 281
WIT.-SAME AS 7-20-72
 - 10-18-74 LAPHAM, (132) L.1, PG. 837
WIT.-FOUND IRON ROD.
SAME WITNESSES AS 7-20-72
 - 1-16-75 LAPHAM, L.C.R.C. #185
WIT.-SAME AS 10-18-74

- 8-1-75 LAPHAM, (132) L.2, PG. 42
WIT.-REFERENCES 1-16-75 L.C.R.C.
- 5-4-92, LAPHAM, L.C.R.C. #672
WIT.-FOUND IRON ROD.
N68°E, 44.33' - 17" OAK.
S67°W, 35.53' - 14" OAK.
S45°E, 47.50' - POWER POLE.
N45°W, 62.86' - 10" RED PINE.
- 4-27-95 CARLSON, (132) L.3, PG. 517
WIT.-REFERENCES 1992 L.C.R.C.

B. Description of corner evidence found and/or method applied in restoring or reestablishing corner:

FOUND 5/8"x12" IRON IN GRAVEL ROAD. FOUND CAPPED IRON 33.00' WEST. FOUND ALL WITNESSES EXCEPT 1992 17" OAK. 1972 10" POPLAR, 17" TWIN OAK AND 10" B. OAK WERE STUMPS.

See dossier for detailed report.


C. Description of monument for corner and accessories established to perpetuate locating the position of the corner:

SET 5/8"x36" RE-ROD WITH 3" STANDARD CLARE COUNTY MONUMENT CAP.
 ACCEPTED AS BEST AVAILABLE EVIDENCE OF THE ACCEPTED POSITION OF THE CORNER.

- WITNESSES:
- N55°E, 62.90' - NAIL & TAG IN 15" POPLAR.
 - N36°E, 90.38' - NAIL & TAG IN 14" RED OAK.
 - N31°W, 79.10' - NAIL & TAG IN 15" RED PINE.
 - S78°W, 52.82' - NAIL & TAG IN 18" RED OAK.
 - S41°E, 47.24' - NAIL & TAG IN POWER POLE (OBT).

APPROVED LAND CORNER
 P.A. 345 of 1990
 Clare County
 Chairman [Signature]
 Date 11-07-90

Signed by Mark R. Robison
 Surveyor's Michigan License No. 27458

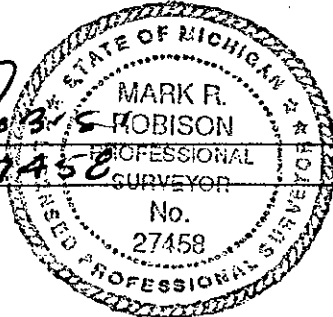

Date 9-23-96