

LAND CORNER RECORDATION CERTIFICATE
Filing Requirement of Act 74, Mich. P.A. 1970

For corners in

<u>CLARE</u> (County)	Located In:	Corner Code #
1. Public Land Survey	T <u>19N</u> R <u>5W</u>	<u>K-10</u>
	T <u> </u> R <u> </u>	<u> </u>
	T <u> </u> R <u> </u>	<u> </u>
	T <u> </u> R <u> </u>	<u> </u>
2. Property Controlling in Section	S <u> </u> T <u> </u> R <u> </u>	<u> </u>
	S <u> </u> T <u> </u> R <u> </u>	<u> </u>
3. Miscellaneous Property in Sec.	S <u> </u> T <u> </u> R <u> </u>	<u> </u>
	S <u> </u> T <u> </u> R <u> </u>	<u> </u>

RECORDED
 E.V.
 #147-96
 95 NOV 14 PM 4:15
 REGISTER OF DEEDS
 CLARE COUNTY
 DONNA M. CARP

Register of Deeds Stamp & File Number

4. Lot No. _____, Recorded Plat _____
 5. Private Claims _____

I, MARK R. ROBISON, in a field survey on AUGUST, 1996 do hereby state that under requirements of P.A. 74, Michigan P.A. of 1970, the corner points mentioned in lines 1 and 2 above were in conformance with regulations and rules therefore as required in the current manual of survey instructions of the United States Department of the Interior, Bureau of Land Management or by a decree of a Court of Law and /or that the corner points mentioned in lines 3, 4 and 5 above were in conformance with the rules of the Michigan Board of Land Surveyors or by a Decree of a Court of Law; established, re-established, monumented, recovered, found as expressed below:

NOTE: Not more than 2 corners, all in the same town and range, may be recorded on this certificate.

A	B	C	D	E	F	G	H	I	J	K	L	M
1												
2	6	5	4	3	2	1						
3												
4	7	8	9	10	11	12						
5												
6	18	17	16	15	14	13						
7												
8	19	20	21	22	23	24						
9												
10	30	29	28	27	26	25						
11												
12	31	32	33	34	35	36						
13												

A. Description of original monument and accessories and/or subsequent restoration:

1857 ADAIR WIT.- SET 1/4 POST B. OAK 12" N45°E 11 1/2 LKS. W. PINE 28" S41°W 47 LKS.	4-1-81 DYER, L.C.R.C. #394 WIT.-FOUND 1/2" BAR. EAST, 33.14', 1/2" BAR. SW, 30.13' - NAIL & TAG IN 24" OAK. SSE, 93.03' NAIL & TAG IN POWER POLE. ESE, 48.71' - NAIL & TAG IN 20" OAK.
6-16-71 LAPHAM, (132) L.1, PG. 16 WIT.-S80°W, 30.60' 3 1/2" POST. S45°W, 29.35' 20" OAK. S70°E, 28.80' 24" OAK. MEAS. 2639.42' TO K-9	9-18-81 LAPHAM, L.C.R.C. #408 WIT.-FOUND 1/2" IRON. SAME AS 6-16-71
5-27-81 LAPHAM, (132) L.2, PG. 644 WIT.-SAME AS 6-16-71 MEAS. 2632.42' NORTH TO K-9	

B. Description of corner evidence found and/or method applied in restoring or reestablishing corner:

FOUND 1/2"x18" IRON, FOUND NO OTHER EVIDENCE, FOUND ONE 1971 WITNESS & CAPPED IRON 33.0' EAST. FOUND FOUR 1981 WITNESSES. MEAS. 2632.67' NORTH TO K-9. IT APPEARS THAT THE 1971 MEASUREMENTS OF 2639.62' TO K-9 WAS RECORDED IN ERROR & SHOULD HAVE BEEN 2632.42'.

See dossier for detailed report.


C. Description of monument for corner and accessories established to perpetuate locating the position of the corner:

SET 5/8"x36" RE-ROD WITH 3" CLARE COUNTY MONUMENT CAP.
 ACCEPTED AS BEST AVAILABLE EVIDENCE OF THE ACCEPTED POSITION OF THE CORNER.

WITNESSES:
 S13°E, 93.17' - NAIL & TAG IN POWER POLE (OBT).
 S65°E, 49.92' - NAIL & TAG IN 26" OAK (OBT).
 S56°W, 29.80' - NAIL & TAG IN 30" OAK (OBT).
 S87°W, 30.60' - NAIL & TAG IN 3" POST (OBT).
 N80°E, 47.25' - NAIL & TAG IN 12" OAK.

APPROVED LAND CORNER
 P.A. 345 of 1980
 Clare County
 Chairman Paul A. Loph
 Date 11-07-96

Signed by Mark R. Robison
 Surveyor's Michigan License No. 27458

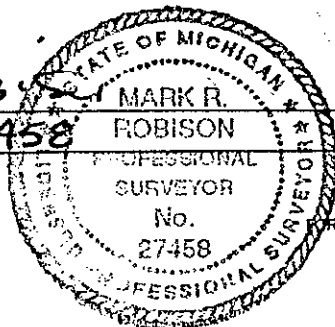

Date 9-23-96