

SURVEY & RE-MONUMENTATION

DEC 1 1995

COMMISSION

LAND CORNER RECORDATION CERTIFICATE
Filing Requirement of Act 74, Mich. P.A. 1970

RECEIVED
E 10 A 1
112-95
95 OCT -3 PM 2:50

REGISTER OF DEEDS
CLARE COUNTY
DONNA M. CARR

For corners in CLARE
(County)

Located In: Corner Code #

- 1. Public Land Survey T 19N R 5W L-7
T _____ R _____
T _____ R _____
T _____ R _____
- 2. Property Controlling S _____ T _____ R _____
in Section S _____ T _____ R _____
- 3. Miscellaneous S _____ T _____ R _____
Property in Section S _____ T _____ R _____

Register of Deeds Stamp & File Number

- 4. Lot No. _____, Recorded Plat _____
- 5. Private Claims _____

A	B	C	D	E	F	G	H	I	J	K	L
2	6	5	4	3	2	1					
3											
4	7	8	9	10	11	12					
5											
6	18	17	16	15	14	13					
7											
8	19	20	21	22	23	24					
9											
10	30	29	28	27	26	25					
11											
12	31	32	33	34	35	36					
13											

I, MARK R. ROBISON, in a field survey on SEPTEMBER, 19 95, do hereby certify that under requirements of P.A. 74, Michigan P.A. of 1970, the corner points mentioned in lines 1 and 2 above were in conformance with regulations and rules therefore as required in the current manual of survey instructions of the United States Department of the Interior, Bureau of Land Management or by a decree of a Court of Law and/or that the corner points mentioned in lines 3, 4 and 5 above were in conformance with the rules of the Michigan Board of Professional Surveyors or by a Decree of a Court of Law; established, re-established, monumented, re-monumented, recovered, found as expressed below:

NOTE: Not more than 4 corners, all in the same town and range, may be recorded on this certificate.

- A. Description of original monument and accessories and/or subsequent restoration:
- L-7: 1/4 Corner common to Sections 13 & 24
1856 ADAIR, W. PINE 10 N47W 72, MAPLE 10 SB 1/2E 6
MDOT, 1 1/2" PIPE
WITNESSES: S77E 17.28' 30" TR. OAK
S27W 33.50' 11" CHERRY
N68W 31.49' 8" MAPLE
 - 8-75 LAPHAM FOUND 2" PIPE L.C.R.C. & (132) SURVEY
WITNESSES: N45E 56.80' 24" OAK
N45W 80.70' POWER POLE
WEST 50.00' 16" OAK
 - 5-76 SEDGMAN, FOUND 2" PIPE L.C.R.C. & THREE (132) SURVEYS
WITNESSES: N35E 57.75' 24" OAK
S75E 17.33' 18" TR. OAK
N50W 80.70' POWER POLE
 - 7-71 COURTRIGHT, SAME AS MDOT L.C.R.C.
 - 8-85 LAPHAM, SAME AS 5-76 ABOVE (132) SURVEY
 - 1-72 MCCLUNG SAME AS MDOT L.C.R.C.
 - 10-87 LAPHAM, SAME AS 5-76 ABOVE (132) SURVEY


- B. Description of corner evidence found and/or method applied in restoring or reestablishing corner:
FOUND 2"x18" PIPE. FOUND WITNESSES PER MDOT, COURTRIGHT, MCCLUNG, LAPHAM & SEDGMAN. MEAS. WEST 2638.25' TO K-7 & EAST 2636.77' TO M-7

APPROVED LAND CORNER
P.A. 345 of 1990
Clare County

Chairman Paul D. Lapham
Date 9-26-95

This Corner established in Clare County Remonumentation Program.
See dossier for detailed report.

- C. Description of monument for corner and accessories established to perpetuate locating the position of the corner:
L-7: 1/4 Corner common to Sections 13 & 24
SET 5/8"x36" RE-ROD WITH 3" CLARE CO. REMON CAP MARKED 1995 P.S. # 27458
ACCEPTED AS BEST AVAILABLE EVIDENCE OF THE ACCEPTED POSITION OF THE CORNER.
WITNESSES:
S79°30'00"E 17.33' - NAIL & TAG IN 12" R. OAK (OBT)
N80°W 61.38' - NAIL & TAG IN 24" R. OAK
N45°W 80.70' - NAIL & TAG IN POWER POLE (OBT)
N45°E 57.75' - NAIL & TAG IN W. OAK (OBT)

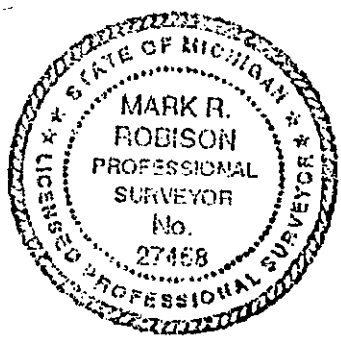

Signed by Mark R. Robison

Date 10-3-95

Surveyor's Michigan License No. 27458