

REMOVAL

NOV 1 8 1997

COMM

CLARE COUNTY REMONUMENTATION

LAND CORNER RECORDATION CERTIFICATE  
Filing Requirement of Act 74, Mich. P.A. 1970

RECEIVED  
# 226-97  
97 OCT 15 AM 10:53

REGISTER OF DEEDS  
CLARE COUNTY  
CAROL A. McAULAY

GREENWOOD  
HAYES  
LINCOLN  
HATTON

Register of Deeds Stamp & File Number

corners in

CLARE  
(County)

Located In:

Corner Code #

Public Land Survey

T 19N R 5W

M-13

T 19N R 4W

A-13

T 18N R 5W

M-1

T 18N R 4W

A-1

- 2. Property Controlling in Section
- 3. Miscellaneous Property in Sec.

S \_\_\_ T \_\_\_ R \_\_\_  
 S \_\_\_ T \_\_\_ R \_\_\_  
 S \_\_\_ T \_\_\_ R \_\_\_  
 S \_\_\_ T \_\_\_ R \_\_\_

- 4. Lot No. \_\_\_\_\_, Recorded Plat \_\_\_\_\_
- 5. Private Claims \_\_\_\_\_

MARK R. ROBISON, in a field survey on July 1, 1997, do hereby state that under requirements of P.A. 74, Michigan P.A. of 1970, the corner points mentioned in lines 1 and 2 above were in conformance with regulations and rules therefore as required in the current manual of survey instructions of the United States Department of the Interior, Bureau of Land Management or by a decree of a Court of Law and/or that the corner points mentioned in lines 3, 4 and 5 above were in conformance with the rules of the Michigan Board of Land Surveyors or by a Decree of a Court of Law; established, re-established, monumented, recovered, found as expressed below:

NOTE: Not more than 2 corners, all in the same town and range, may be recorded on this certificate.

	A	B	C	D	E	F	G	H	I	J	K	L	M
1													
2	6		5		4		3		2		1		
3													
4	7		8		9		10		11		12		
5													
6	18		17		16		15		14		13		
7													
8	19		20		21		22		23		24		
9													
10	30		29		28		27		26		25		
11													
12	31		32		33		34		35		36		
13													

- A. Description of original monument and accessories and/or subsequent restoration:  
 1838 Nicholson  
 Set Post Cor of T18 & 19N, R4 & 5W.  
 Wit.-Pine 26" S82W 40  
 Pine 28" S84E 61  
 6-29-12 Johnson C.S.R. 2-16 & 6-37  
 Tile for Sec. Cor.  
 Wit.-F. Post 8" S35W 18  
 M-13 to L-13, 40.20

- 9-14-12 Johnson C.S.R. 2-21  
 Corner is tile  
 M-13 to K-13 81.60  
 9-21-12 Johnson C.S.R. 2-22  
 Cor is tile  
 A-13 to B-13 (Hayes) 43.32  
 Undated C.S.R. 6-247  
 A-13 to B-13 (Hayes) 43.04

11-29-89 Lapham L.C.R.C.# 594  
Found 1/2" rod in Fence Cor.  
Wit.-N60E 56.1 4" W. Oak  
N20E 49.3 15" Oak  
S70E 31.6 6" Maple  
S40E 51.1 4" Maple

- B. Description of corner evidence found and/or method applied in restoring or reestablishing corner:  
 Found clay tile 1.5 feet South of capped iron per L.C.R.C.#594. Tile is 0.6 ft. SE of 10" Fence Post Corner for fences North, South, East, & West. Found three 1989 witnesses that fit capped iron. Accepted tile as Corner.

APPROVED LAND CORNER  
P.A. 345 of 1990  
Clare County


Chairman Paul A. Lepko  
Date 9-23-97

See dossier for detailed report.

- C. Description of monument for corner and accessories established to perpetuate locating the position of the corner:

M-13: Corner common to Section 36, T19N, R5W, (M-13); Section 1, T18N, R5W, (M-1); Section 31, T19N, R4W, (A-13); and Section 6, T18N, R4W, (A-1). Set 5/8" x 36" rod with 3" Clare County Monument Cap marked P.S.#27458. Accepted as best available evidence of perpetuation of C.S.R. Corner.

Witnesses:  
S22E 49.4', N&T, 6" & 8" Twin Maple  
S26E 51.15', N&T, 18" Red Oak  
N73W 9.30', N&T, 20" Maple  
N73W 9.30', N&T, 20" Maple

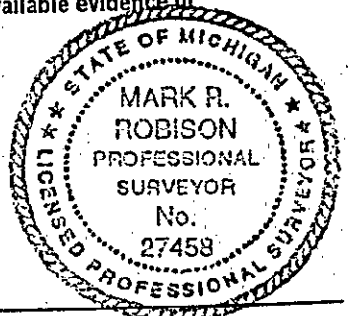

Signed by Mark R. Robison  
Surveyor's Michigan License No. 27458

Date 10-01-97