

MAR 24 2000

SECTION

LAND CORNER RECORDATION CERTIFICATE
Filing Requirement of Act 74, Mich. P.A. 1970
Clare County Remonumentation

For Corners in
Clare

(County)

Located In:

Corner Code#:

- | | | |
|---|----------------------------|-------------|
| 1. Public Land Survey | T. <u>19N</u> R. <u>6W</u> | <u>B-13</u> |
| | T. <u>18N</u> R. <u>6W</u> | <u>B-1</u> |
| | T. _____ R. _____ | _____ |
| 2. Public Controlling
in Section | S. _____ T. _____ R. _____ | _____ |
| | S. _____ T. _____ R. _____ | _____ |
| 3. Miscellaneous
Property in Section | S. _____ T. _____ R. _____ | _____ |
| | S. _____ T. _____ R. _____ | _____ |
| 4. Lot No. _____, Recorded Plat _____ | | |
| 5. Private Claims _____ | | |

199900009771
Filed for Record in
CLARE COUNTY MICHIGAN
CAROL MCAULAY
On 11-10-1999 At 01:30 pm.
LAND CORNER 9.00
DR Liber 2 Page 50 - 50

Instrument 199900009771 OR Liber 2 Page 50

361-99

Register of Deeds Stamp & File Number

I, Mark R. Robison, in a field survey on ~~11-10-1999~~ 8-11-99, do hereby certify that under requirements of P.A. 74, Michigan P.A. of 1970, the corner points mentioned in lines 1 and 2 above were in conformance with regulations and rules therefore as required in the current manual of survey instructions of the United States Department of the Interior, Bureau of Land Management or by a decree of a Court of Law and/or that the corner points mentioned in lines 3, 4 and 5 above were in conformance with the rules of the Michigan Board of Land Surveyors or by a Decree of a Court of Law, established, re-established, monumented, re-monumented, recovered, found as expressed below.

NOTE: Not more than 2 corners, all in the same town and range, may be recorded on this certificate.

1	A	B	C	D	E	F	G	H	I	J	K	L	M
2	6	5	4	3	2	1							
3													
4	7	8	9	10	11	12							
5													
6	18	17	16	15	14	13							
7													
8	19	20	21	22	23	24							
9													
10	30	29	28	27	26	25							
11													
12	31	32	33	34	35	36							
13													

A. Description of original monument and accessories and/or subsequent restoration:

1838 Roisseau
East 39.00 Set 1/4 Sec Post
Hemlock 14" N50E 3
Fir 5" S70W 15

01-06-86 Roser LCRC #524 & Dwg #31-93124
Fd & accepted 1" pipe by McClung. Cor fits
S.P. to U.S. BETW NW Sec 6 & NE Sec 6.
Added Ced. Post N60W 53.2 10" B. Oak
N35E 28.2 18" Tw. B. Oak
S10E 34.2 8" B. Oak
S50W 49.9 7" B. Oak
West 257' CTR. Trail Rd
Meas. W 2533.57 to A-13
Meas. E 2597.36 to C-13

1974 McClung, (132) 2-205
Set 1" Pipe with ID Cap
N35E 28.5 15" Dbl. R. Oak
N50W 53.4 8" R. Oak

1977 McClung Unrec Survey
Same witnesses as (132) 2-205

B. Description of corner evidence found and/or method applied in restoring or re-establishing corner:
See dossier for detailed report.

Found 3/4" x 48" pipe. Found all 1974 and 1986 witnesses except 7" black oak (DNR) that was destroyed by windstorm.

C. Description of monument for corner and accessories established to perpetuate locating the position of the corner:

Set 5/8" x 36" rerod w/Clare Co. Remon Cap marked P.S. #27458. Accepted as best available evidence of the accepted position of the corner.


Witnesses:

N60°W 53.20 N & T in 10" B. Oak (OBT)
N35°E 28.20 N & T in 20" B. Oak (OBT)
S10°E 34.20 N & T in 12" B. Oak (OBT)
S52°W 53.70 N & T in 10" B. Oak
East 1.75 N & T in D.N.R. Cedar Post

APPROVED LAND CORNER
P.A. 345 of 1990
Clare County

Chairman Paul D. Lapham

Date 9-29-99

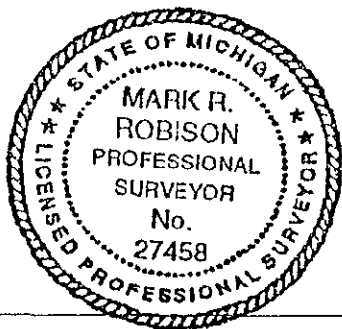

Signed by Mark R. Robison
Surveyor's Michigan License No. 27458

Date 11-8-99