


CLARE County Remonumentation

LAND CORNER RECORDATION CERTIFICATE
Filing Requirement of Act 74, Mich. P.A. 1970

For corners in

| | | |
|---------------------------------------|-------------------|---------------|
| <u>CLARE</u> (County) | Located in: | Corner Code # |
| 1. Public Land Survey | T19N R06W | E-7 |
| | T ___ R ___ | _____ |
| | T ___ R ___ | _____ |
| | T ___ R ___ | _____ |
| 2. Property Controlling in Section | S ___ T ___ R ___ | _____ |
| | S ___ T ___ R ___ | _____ |
| 3. Miscellaneous Property in Sec. | S ___ T ___ R ___ | _____ |
| | S ___ T ___ R ___ | _____ |

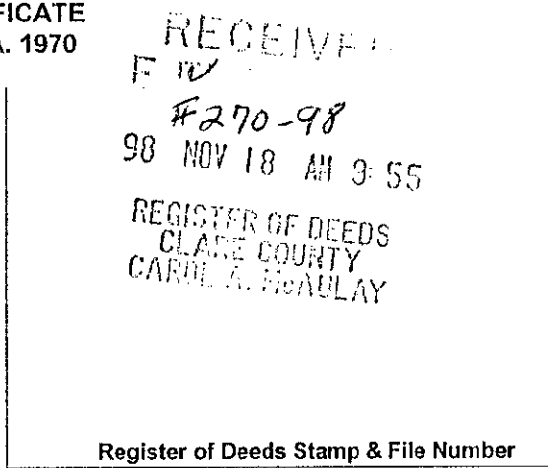

4. Lot No. _____, Recorded Plat _____
5. Private Claims _____

I, Mark R Robison, in a field survey on May 15, 1998 do hereby state that under requirements of P.A. 74, Michigan P.A. of 1970, the corner points mention in lines 1 and 2 above were in conformance with regulations and rules therefore as required in the current manual of survey instructions of the United States Department of the Interior, Bureau of Land Management or by a decree of a Court of Law and/or that the corner points mentioned in lines 3, 4 and 5 above were in conformance with the rules of the Michigan Board of Land Surveyors or by a Decree of a Court of Law; established, re-established, monumented, recovered, found as expressed below:

| A | B | C | D | E | F | G | H | I | J | K | L | M |
|----|----|---|----|---|----|---|----|---|----|---|----|---|
| 1 | | | | | | | | | | | | |
| 2 | 6 | | 5 | | 4 | | 3 | | 2 | | 1 | |
| 3 | | | | | | | | | | | | |
| 4 | 7 | | 8 | | 9 | | 10 | | 11 | | 12 | |
| 5 | | | | | | | | | | | | |
| 6 | 18 | | 17 | | 16 | | 15 | | 14 | | 13 | |
| 7 | | | | | | | | | | | | |
| 8 | 19 | | 20 | | 21 | | 22 | | 23 | | 24 | |
| 9 | | | | | | | | | | | | |
| 10 | 30 | | 29 | | 28 | | 27 | | 26 | | 25 | |
| 11 | | | | | | | | | | | | |
| 12 | 31 | | 32 | | 33 | | 34 | | 35 | | 36 | |
| 13 | | | | | | | | | | | | |

NOTE: Not more than 2 corners, all in the same town and range, may be recorded on this certificate

A. Description of original monument and accessories and/or subsequent restoration:

| | | |
|--|--|---|
| E-7: 1856 Coleman GLO Set Post Cor Sec 16-17-20-21 Wit-Cedar 8 N20E 21 Hem 7 S36W 11 | hole 25 links West of old road. Wit-S19W 17 20" W. Pine Stp. N61W 122 1/2 28" W. Pine Stp. N33E 116 18" Ced Stp. | Schaff notes (1940) indicate he had Gov't Cor. Fd Old 2" pipe; added Ced Post Wit-N50E 12.5 14" Maple S20E 18.9 16" B. Cherry S40W 21.7 9" Maple |
| 9-2-11 Johnson CSR 2-08 Wit-Pine 16" N70W 38 Cedar 16 S39W 25 1/2 All Gov't corners found | circa 1960, Unknown, MSHD. Corner is 3" Post Wit-S53E 15.22 4" Elm N36E 22.55 8" Cherry N39W 15.65 10" Cherry | East 19.9 6" x 60" pipe w/conc gate post East 27' Ctr. N-S trail |
| 1940 Schaaf DNR (Note: Dim are in Links) Fd NE Cedar Stump & SW | 01-06-86 Roser LCRC#494 Fd and Accepted M. Schaaf pipe for NW Cor Sec 21. | |

SURVEY & REMONUMENTATION

NOV 25 1998

SECTION

B. Description of corner evidence found and/or method applied in restoring or reestablishing corner:

E-7: Found 2" pipe and three 1940 witnesses and all 1986 witnesses. Did not find 1911 or 1960 witnesses.


See dossier for detailed report.

C. Description of monument for corner and accessories established to perpetuate locating the position of the corner:

E-7: E-7: Set 5/8" x 36" Clare County Remonumentation Cap marked P.S.#27458. Accepted as best available evidence of the perpetuation of the original government corner.

Witnesses:

- N50E 12.50', nail & tag, 18" Maple (OBT)
- S20E 18.90', nail & tag, 20" B. Cherry (OBT)
- S40W 21.70', nail & tag, 13" Maple (OBT)
- East 19.90' 6" x 60" Pipe with Concrete Gate Post
- East 27' Center of North-South Trail

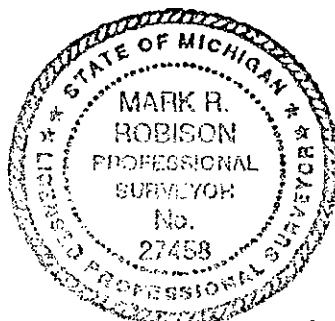

APPROVED LAND CORNER
P.A. 345 of 1990
Clare County
Chairman [Signature]
Date 9-22-98

Signed by [Signature]
Surveyor's Michigan License No. 27458

Date 11-16-98