

**SURVEY & REMONUMENTATION**

**MAR 24 2000**

**LAND CORNER RECORDATION CERTIFICATE**

**Filing Requirement of Act 74, Mich. P.A. 1970**

**Clare County Remonumentation**

**SECTION**

For Corners in

Clare

(County)

Located In:

Corner Code#:

- 1. Public Land Survey T. 19N R. 6W E-13  
T. 18N R. 6W E-1  
T. \_\_\_\_\_ R. \_\_\_\_\_ E-\_\_\_\_\_
- 2. Public Controlling S. \_\_\_\_\_ T. \_\_\_\_\_ R. \_\_\_\_\_  
in Section S. \_\_\_\_\_ T. \_\_\_\_\_ R. \_\_\_\_\_
- 3. Miscellaneous S. \_\_\_\_\_ T. \_\_\_\_\_ R. \_\_\_\_\_  
Property in Section S. \_\_\_\_\_ T. \_\_\_\_\_ R. \_\_\_\_\_
- 4. Lot No. \_\_\_\_\_, Recorded Plat \_\_\_\_\_
- 5. Private Claims \_\_\_\_\_

199900009769  
Filed for Record in  
CLARE COUNTY MICHIGAN  
CAROL MCAULAY  
On 11-10-1999 At 01:30 pm.  
LAND CORNER 9.00  
OR Liber 2 Page 48 - 48

Instrument 199900009769 OR Liber 2 Page 48

*# 359-99*

**Register of Deeds Stamp & File Number**

I, Mark R. Robison, in a field survey on August 12, 1999, do hereby certify that under requirements of P.A. 74, Michigan P.A. of 1970, the corner points mentioned in lines 1 and 2 above were in conformance with regulations and rules therefore as required in the current manual of survey instructions of the United States Department of the Interior, Bureau of Land Management or by a decree of a Court of Law and/or that the corner points mentioned in lines 3, 4 and 5 above were in conformance with the rules of the Michigan Board of Land Surveyors or by a Decree of a Court of Law, established, re-established, monumented, re-monumented, recovered, found as expressed below.

**NOTE: Not more than 2 corners, all in the same town and range, may be recorded on this certificate.**

This is a single corner common to T19N, R6W, E-13 and T18N, R6W, E-1

	A	B	C	D	E	F	G	H	I	J	K	L	M
2	6	5	4	3	2	1							
3													
4	7	8	9	10	11	12							
5													
6	18	17	16	15	14	13							
7													
8	19	20	21	22	23	24							
9													
10	30	29	28	27	26	25							
11													
12	31	32	33	34	35	36							
13													

**A. Description of original monument and accessories and/or subsequent restoration:**

1838 Rousseau  
Set Post Cor Sec. 32-33  
Birch 4 N85E 20  
Birch 3 N50W 14

Circa 1900 Unknown, CSR 6-185-186  
E-1 to G-1 80 Ch  
E-1 to C-1 80 Ch

2-75 McClung LCRC #189  
Set 3/4" rod by proportional meas.  
Same witnesses as (132) 1-933

2-92 McClung, (132) 3-351  
Same witnesses as LCRC #526

2-75 McClung, (132) 1-933  
Set Sec Cor - 3/4" Sucker Rod  
S45E 46.75 6" W. Pine  
N45E 77.20 10" W. Pine

01-86 Roser LCRC #526 & Dwg #31-93124  
Fd & accepted 1" pipe & 5/8" rod by McClung.  
S70E, 76.0 13" W. Pine  
S35E, 47.22 6" W. Pine  
S10E, 92.29 4" W. Pine  
S45W, 50' Set Ced. Post  
West 15.0' Fd R.R. Spike  
Meas. W, 2610.09  
Meas. E, 2617.69

3-74 McClung, (132) 1-934  
Same as (132) 1-933  
Meas. West 2611.60 To D-1


**B. Description of corner evidence found and/or method applied in restoring or re-establishing corner:**  
See dossier for detailed report.

Found & accepted female end sucker rod beside 5/8" sucker rod for corner. Found all 1986 witnesses and one 1975 witness. Found and removed R.R. Spike 14.9 feet West of corner. Corner falls 15 feet East of C.L. sand road (N-S) and 3 feet South of C.L. sand road (E-W).

**C. Description of monument for corner and accessories established to perpetuate locating the position of the corner:**  
Set 5/8" x 36" rerod with Clare Co. Remon Cap marked P.S. #27458. Accepted as best available evidence of the accepted position of the corner.

Witnesses:  
N48°E 94.70, N & T in 14" Pine  
S63°E 76.15, Fd Spike in 20" Pine (OBT)  
S32°E 47.08, Fd Spike in 12" Pine (OBT)  
S10°E 92.25, Fd Spike in 10" Pine (OBT)

Signed by Mark R. Robison  
Surveyor's Michigan License No. 27458

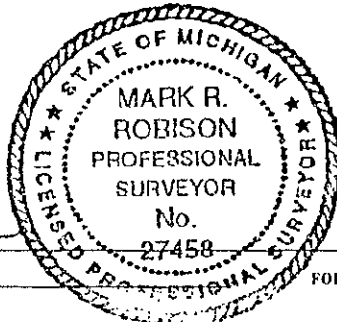

**APPROVED LAND CORNER**  
P.A. 345 of 1990  
Clare County  
Chairman Paul S. Lopez  
Date 9-29-99

Date 11-8-99