

**MAR 24 2000**

**LAND CORNER RECORDATION CERTIFICATE**  
**Filing Requirement of Act 74, Mich. P.A. 1970**  
**Clare County Remonumentation**

199900009772  
 Filed for Record in  
 CLARE COUNTY MICHIGAN  
 CAROL MCAULAY  
 On 11-10-1999 At 01:30 pm.  
 LAND CORNER 9.00  
 OR Liber 2 Page 51 - 51

For Corners in  
Clare

(County)	Located In:	Corner Code#:
1. Public Land Survey	T. 19N R. 6W	G-13
	T. 18N R. 6W	G-1
	T. _____ R. _____	_____
2. Public Controlling in Section	S. _____ T. _____ R. _____	_____
	S. _____ T. _____ R. _____	_____
3. Miscellaneous Property in Section	S. _____ T. _____ R. _____	_____
	S. _____ T. _____ R. _____	_____
4. Lot No. _____, Recorded Plat _____		
5. Private Claims _____		

Instrument 199900009772 OR  
 Liber Page 2 51

# 362-99

Register of Deeds Stamp & File Number

I, Mark R. Robison, in a field survey on August 11, 1999, do hereby certify that under requirements of P.A. 74, Michigan P.A. of 1970, the corner points mentioned in lines 1 and 2 above were in conformance with regulations and rules therefore as required in the current manual of survey instructions of the United States Department of the Interior, Bureau of Land Management or by a decree of a Court of Law and/or that the corner points mentioned in lines 3, 4 and 5 above were in conformance with the rules of the Michigan Board of Land Surveyors or by a Decree of a Court of Law, established, re-established, monumented, re-monumented, recovered, found as expressed below.

	A	B	C	D	E	F	G	H	I	J	K	L	M
1													
2	6	5	4	3	2	1							
3													
4	7	8	9	10	11	12							
5													
6	18	17	16	15	14	13							
7													
8	19	20	21	22	23	24							
9													
10	30	29	28	27	26	25							
11													
12	31	32	33	34	35	36							
13													

NOTE: Not more than 2 corners, all in the same town and range, may be recorded on this certificate.

This is a single corner common to T19N, R6W, G-13 and T18N, R6W, G-1

**A. Description of original monument and accessories and/or subsequent restoration:**

1838 Rousseau  
 Set Post Cor. 33-34  
 Swp. Ash 13 N50E 10  
 Birch 10 N61W 50

Circa 1900, CSR 6-251  
 Fence Post 8" N42W 74  
 G-13 to H-13, 39.75

10-9-01 Harper, CSR 1-08 & 4-09  
 Stake & Stone. Witnessed large stone marked (X) N61E 12 L.  
 G-1 & I-1, 78.36

8-23-38 Johnson, CSR 1-39 & 2-105  
 Old corner found  
 Stake intersection hwy.

01-06-86 Roser LCRC #508 & Dwg #31-93124  
 Fd & Accepted 2" pipe in road intersection  
 Cor is in approx ctr. of E-W gravel road.  
 Ctr. of N-S gravel rd is West 4'  
 N50W 107.55 P.P.  
 N25E 60.62 P.P.  
 S50W 44.05 Cor. Fn. Post  
 Meas. W 2617.34 to F-13

11-29-89 Lapham LCRC #51  
 Fd 1/2" Pipe  
 S45W 44.13 Cor. Fn. Post  
 N45E 60.63 P.P.  
 S45E 42.25 Cor. Fn. Post  
 S60W 78.85 Fn. Post

12-20-92 Erickson LCRC #737  
 Fd 2" Pipe  
 N32E 60.67 P.K. in P.P.  
 S42E 42.75 Nail in Cor. F. Post  
 S55W 44.15 Nail in Cor. F. Post  
 N45W 107.65 P.K. in P.P.

**B. Description of corner evidence found and/or method applied in restoring or re-establishing corner:**


See dossier for detailed report.  
 Did not find 2" pipe. Found 1/2" x 18" re-rod over very old pointed cedar stake surrounded by broken pieces of tile and large stones. Cor fit witnesses quite well. Meas. West 2617.14 to F-13. Meas. East 2615.97 to H-13.

**C. Description of monument for corner and accessories established to perpetuate locating the position of the corner:**

Set 5/8" x 36" re-rod with Clare Co. Remon Cap marked P.S. #27458. Accepted as best available evidence of perpetuation of CSR corner.

Witnesses:  
 N35°E 60.56 Fd N & T in P.P. (OBT)  
 S45°E 37.17 Two inch pipe road sign  
 S70°W 61.34 Set H & T in 6" W. Pipe  
 N41°W 107.13 Fd N & T in Service Dots (OBT)  
 S55°W 44.20 Fd H & T in Cor. F. Post (OBT)

Signed by \_\_\_\_\_  
 Surveyor's Michigan License No. 27458

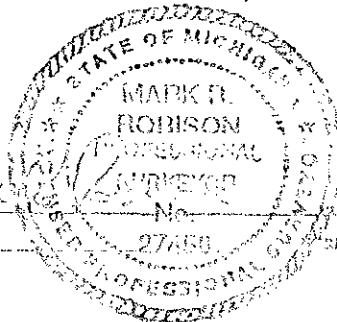

APPROVED LAND CORNER  
 P.A. 345 of 1990  
 Clare County  
 Chairman \_\_\_\_\_  
 Date 11-8-99

Date 11-8-99  
 RE-APPROVED BY MICHIGAN STATE BOARD OF LAND SURVEYORS, JAN 11