

MAR 24 2000

LAND CORNER RECORDATION CERTIFICATE
Filing Requirement of Act 74, Mich. P.A. 1970
Clare County Remonumentation

SECTION

For Corners in
Clare

Table with columns: (County), Located In:, Corner Code#:
1. Public Land Survey T. 19N. R. 6W H-13
T. 18N R. 6W H-1
2. Public Controlling S. T. R.
in Section S. T. R.
3. Miscellaneous S. T. R.
Property in Section S. T. R.
4. Lot No. Recorded Plat
5. Private Claims

199900009773
Filed for Record in
CLARE COUNTY MICHIGAN
CAROL MCAULAY
On 11-10-1999 At 01:30 pm.
LAND CORNER 9.00
OR Liber 2 Page 52 - 52

Instrument Liber Page
199900009773 OR 2 52

# 363-99

Register of Deeds Stamp & File Number

I, Mark R. Robison, in a field survey on August 11, 1999, do hereby certify that under requirements of P.A. 74, Michigan P.A. of 1970, the corner points mentioned in lines 1 and 2 above were in conformance with regulations and rules therefore as required in the current manual of survey instructions of the United States Department of the Interior, Bureau of Land Management or by a decree of a Court of Law and/or that the corner points mentioned in lines 3, 4 and 5 above were in conformance with the rules of the Michigan Board of Land Surveyors or by a Decree of a Court of Law. established, re-established, monumented, re-monumented, recovered, found as expressed below.

Grid table with columns A-M and rows 1-13 containing numbers 1-36.

NOTE: Not more than 2 corners, all in the same town and range, may be recorded on this certificate.

This is a single corner common to
T19N, R6W, H-13 and T18N, R6W, H-1

A. Description of original monument and accessories and/or subsequent restoration:

1838 Rousseau
Set 1/4 Sec. Post
Maple 10" S60W 3
Hemlock 10" N5E 8

Circa 1900, CSR 6-251
H-13 to G-13, 39.75
H-13 to I-13, 39.91

9-38 Unknown, CSR 2-105
H-1 to G-1, 39.75
H-1 to I-1, 39.75

10-01 Harper, CSR 1-8 & 4-9
Cedar stake & stone
NW 10 1. 2" Poplar

11-29-89 Lapham LCRC #597
Set 1/2" x 18" mid-way on line
S30E 30.03 fence post
S45W 44.7 fence post
N05E 70.9 8" Poplar
N15E 70.56 6" Poplar

12-30-92 Erickson LCRC #738
Fd 1/2" rebar 6' South of CL gravel rd.
Also fd. 1/2" pipe bent over to East 1.4' South.
N15E 70.81 Nail in 8" Aspen
N30E 70.42 Nail in 8" Aspen
N61W 79.77 N & T in P.P.
S05W 33.14 C.I. 9433
S58W 44.74 Nail in Fen. Post
S21E 29.99 Nail in Fen. Post

8-16-90 Robison, Liber 611 Pg. 189
References Corner in Survey

B. Description of corner evidence found and/or method applied in restoring or re-establishing corner:

See dossier for detailed report.


Fd 1/2" x 18" rebar and all 1989 and 1992 witnesses (one fence post knocked down). Fd 1/2" pipe 1.5' South of rebar. Removed pipe and excavated but found no further material. Accepted rebar and excavated to 3 feet but found no further material. Meas East 2615.70 to I-13 and Meas. West 2615.97 to G-13.

C. Description of monument for corner and accessories established to perpetuate locating the position of the corner:

Set 5/8" x 36" rerod with Clare Co. Remon Cap marked P.S. #27458. Accepted as best available evidence of the accepted position of the corner.

Witnesses:

N62°W 79.60 N & T in P.P. (OBT)
N04°W 96.87 Set N & T in 6" x 4" Tw. Maple
N42°E 107.00 Set N & T in 12" W. Pine
N78°E 167.92 Set N & T in P.P.

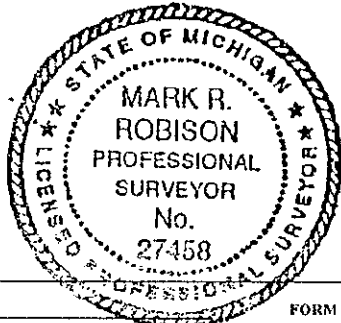

APPROVED LAND CORNER
P.A. 345 of 1990
Clare County
Chairman [Signature]
Date 9-29-99

Signed by [Signature]
Surveyor's Michigan License No. 27458

Date 11-8-99