

CLARE County Remonumentation  
**LAND CORNER RECORDATION CERTIFICATE**  
 Filing Requirement of Act 74, Mich. P.A. 1970

For corners in

CLARE  
 (County)

Located in:

Corner Code #

1. Public Land Survey

T19N R06W

I-7

T R

T R

T R

2. Property Controlling in Section

S

T R

3. Miscellaneous Property in Sec.

S

T R

S

T R

S

T R

RECEIVED  
 #273-98  
 98 NOV 18 AM 9:55  
 REGISTER OF DEEDS  
 CLARE COUNTY  
 CAROL A. BEAULAY

Register of Deeds Stamp & File Number

4. Lot No. \_\_\_\_\_, Recorded Plat \_\_\_\_\_

5. Private Claims \_\_\_\_\_

I, Mark R Robison, in a field survey on May 15, 1998 do hereby state that under requirements of P.A. 74, Michigan P.A. of 1970, the corner points mention in lines 1 and 2 above were in conformance with regulations and rules therefore as required in the current manual of survey instructions of the United States Department of the Interior, Bureau of Land Management or by a decree of a Court of Law and/or that the corner points mentioned in lines 3, 4 and 5 above were in conformance with the rules of the Michigan Board of Land Surveyors or by a Decree of a Court of Law; established, re-established, monumented, recovered, found as expressed below:

**NOTE: Not more than 2 corners, all in the same town and range, may be recorded on this certificate**

A. Description of original monument and accessories and/or subsequent restoration:


I-7: 1856 Coleman GLO  
 79.14 Re est. old cor secs 14-15-22-23  
 Wit-Y. Pine 8 N19W 4.18  
 Y. Pine 16 S15E 75  
 1940 Schaaf DNR; Fd cor in center of gravel road. Fd SE BT and site & hole of NW one.  
 Wit-S66 1/2E 2.53 16" Y. Pine  
 S65E 2.65 16" Y. Pine Stump  
 S44E 1.36 18" Y. Pine Stump  
 circa 1960 Koivisto MSHD Fd 1 1/4" Pipe  
 Wit-N55W 79.10 7" Poplar  
 S52W 75.55(?) 12" Oak & S27E 93.45 11" Oak  
 3-27-72 Ostling Fd & perpetuated by MDSH.  
 Monument box in place.

4-75 Lapham (132)1-985 Fd 1/2" pipe Mon Box  
 Wit-N05E 74.25 Centerline Conc R/W Mon  
 S30E 114.25 Culvert Guard Post  
 S30W 105.83 Culvert Guard Post  
 7-23-75 Sedgman Ref Cert#186-75  
 (Note: 186-75 does not contain I-7)  
 8-20-75 Lapham Wit's-same as (132)1-985  
 01-06-86 Roser LCRC#499; Fd 1" pipe in Mon Box  
 in cir E-W bit Rd  
 Wit-S20W 196.10 P.P.  
 N50W 128.65 9" B. Oak  
 S45W 66" Set Ced. Post

**SURVEY & REMONUMENTATION**

NOV 25 1998

SECTION

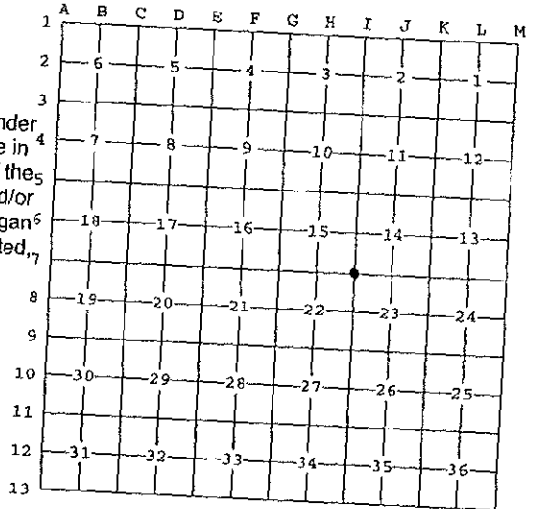


B. Description of corner evidence found and/or method applied in restoring or reestablishing corner:

I-7: Found 3/4" pipe in Monument Box in centerline of Highway. Found all 1975 witnesses and one 1986 witness. Measured West 2614.58 to H-7. Measured East 2639.06 (recorded 2639.05) to J-7.  
 See dossier for detailed report.

C. Description of monument for corner and accessories established to perpetuate locating the position of the corner:  
 I-7: I-7: Set Clare County Remonumentation Cap marked P.S.#27458 on existing 3/4" pipe. Filled Monument Box with concrete around pipe. Accepted as best available evidence of the accepted position of the corner.

Witnesses:  
 N05E 74.25' Centerline Concrete R/W Monument (OBT)  
 S30E 114.25' nail & tag, Culvert Guard Post (OBT)  
 S30W 105.83', nail & tag, Culvert Guard Post (OBT)  
 S20W 196.10', nail & tag, P.P. (OBT)

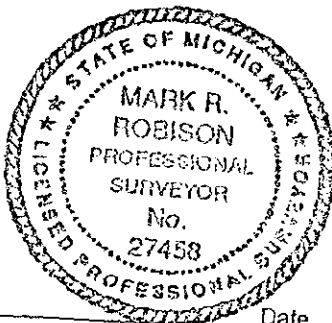

**APPROVED LAND CORNER**

P.A. 345 of 1990

Clare County

Chairman David H. Apple

Date 9-22-98

Signed by Mark R. Robison  
 Surveyor's Michigan License No. 27458

Date 11-16-98