

CLARE County Remonumentation

LAND CORNER RECORDATION CERTIFICATE RECEIVED
Filing Requirement of Act 74, Mich. P.A. 1970

For corners in

CLARE Located in: Corner Code #
(County)

1. Public Land Survey T20N R06W J-13
T19NR06W J-1
T R
T R

2. Property Controlling S T R
in Section S T R

3. Miscellaneous S T R
Property in Sec. S T R

293-98
98 NOV 18 AM 9:57
REGISTER OF DEEDS
CLARE COUNTY
CAROL A. MAULAY
Register of Deeds Stamp & File Number

4. Lot No. _____, Recorded Plat _____
5. Private Claims _____

I, Mark R Robison, in a field survey on May 28, 1998 do hereby state that under requirements of P.A. 74, Michigan P.A. of 1970, the corner points mention in lines 1 and 2 above were in conformance with regulations and rules therefore as required in the current manual of survey instructions of the United States Department of the Interior, Bureau of Land Management or by a decree of a Court of Law and/or that the corner points mentioned in lines 3, 4 and 5 above were in conformance with the rules of the Michigan Board of Land Surveyors or by a Decree of a Court of Law; established, re-established, monumented, recovered, found as expressed below:

1	A	B	C	D	E	F	G	H	I	J	K	L	M
2		6		5		4		3		2		1	
3													
4		7		8		9		10		11		12	
5													
6		18		17		16		15		14		13	
7													
8		19		20		21		22		23		24	
9													
10		30		29		28		27		26		25	
11													
12		31		32		33		34		35		36	
13													

NOTE: Not more than 2 corners, all in the same town and range, may be recorded on this certificate

This is a single corner common to T20N, R06W J-13 and T19N, R06W J-1

A. Description of original monument and accessories and/or subsequent restoration:

- J-13: 1838 Nicholson
W. Pine 12" for 1/4 Section Post
- 12-15-76 Ostling LCRC#273&Plat of Survey
Set by proportionate measurement, MPOL,
between section corners. Matches up
generally with old fence East & South.
Nothing for previous corner.
Set DNR Mon & red-top Post
Wit-N73E 40.4 11" Oak
S04E 19.0 4" Oak

SURVEY & REMONUMENTATION

NOV 25 1998

SECTION

B. Description of corner evidence found and/or method applied in restoring or reestablishing corner:


- J-13: Found DNR Monument and both witnesses. The 4" Oak was dead.

See dossier for detailed report.

C. Description of monument for corner and accessories established to perpetuate locating the position of the corner:

- J-13: Accepted DNR Monument as Clare County Remonumentation Monument. Accepted as best available evidence of the proper method of re-establishment of the Corner.

- Witnesses:
N73E 40.40', nail & tag, 16" Oak (OBT)
S13E 34.43', nail & tag, 12" Oak
N27E 10.02', nail & tag, 9" J. Pine
S49W 17.78', nail & tag, 9" J. Pine

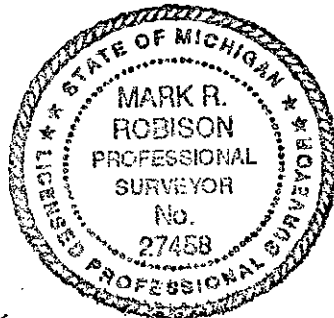

APPROVED LAND CORNER
P.A. 345 of 1990
Clare County
Chairman [Signature]
Date 9-22-98

Signed by [Signature]
Surveyor's Michigan License No. 27458

Date 11-16-98