

SURVEY & REMONUMENTATION

DEC 01 1995

COMMISSION

LAND CORNER RECORDATION CERTIFICATE  
Filing Requirement of Act 74, Mich. P.A. 1970

RECEIVED  
E D L O A D  
#116-95  
95 OCT -3 PM 2:51  
REGISTER OF DEEDS  
CLARE COUNTY  
DONNA M. CARR

For corners in CLARE Located In: \_\_\_\_\_ Corner Code # \_\_\_\_\_  
(County)

1. Public Land Survey T 19N R 6W M-7  
T \_\_\_\_\_ R \_\_\_\_\_  
T \_\_\_\_\_ R \_\_\_\_\_  
T \_\_\_\_\_ R \_\_\_\_\_

2. Property Controlling S \_\_\_\_\_ T \_\_\_\_\_ R \_\_\_\_\_  
in Section S \_\_\_\_\_ T \_\_\_\_\_ R \_\_\_\_\_

3. Miscellaneous S \_\_\_\_\_ T \_\_\_\_\_ R \_\_\_\_\_  
Property in Section S \_\_\_\_\_ T \_\_\_\_\_ R \_\_\_\_\_

4. Lot No. \_\_\_\_\_, Recorded Plat \_\_\_\_\_

5. Private Claims \_\_\_\_\_

Register of Deeds Stamp & File Number

A	B	C	D	E	F	G	H	I	J	K	L
2	6	5	4	3	2	1					
3											
4	7	8	9	10	11	12					
5											
6	18	17	16	15	14	13					
7											
8	19	20	21	22	23	24					
9											
10	30	29	28	27	26	25					
11											
12	31	32	33	34	35	36					
13											

I, MARK R. ROBISON, in a field survey on SEPTEMBER, 19 95, do hereby certify that under requirements of P.A. 74, Michigan P.A. of 1970, the corner points mentioned in lines 1 and 2 above were in conformance with regulations and rules therefore as required in the current manual of survey instructions of the United States Department of the Interior, Bureau of Land Management or by a decree of a Court of Law and/or that the corner points mentioned in lines 3, 4 and 5 above were in conformance with the rules of the Michigan Board of Professional Surveyors or by a Decree of a Court of Law; established, re-established, monumented, re-monumented, recovered, found as expressed below:

NOTE: Not more than 4 corners, all in the same town and range, may be recorded on this certificate.

A. Description of original monument and accessories and/or subsequent restoration:  
M-7: 13-24 SEC. CORNER ON TWP. LINE

1838 NICHOLSON, HEMLOCK 14 N52E 36, W. PINE 18 S45E 65

UNDATED NO SURVEYOR IDENTIFIED, PINE 16 N63-30E 147, PINE 16 S48E 144, CSR

MDOT NO WITNESSES, CORNER FALLS 2.06 SOUTH OF TANGENT, MEASURES 2646.02 TO A-6  
MEASURES 2570.65 TO A-8

B. Description of corner evidence found and/or method applied in restoring or reestablishing corner:  
FOUND 1" IRON IN MON BOX. CORNER FALLS 1.55 NORTH OF CONSTRUCTED CENTER-LINE OF M-61.  
COULD NOT REMOVE IRON

MEASURES EAST 4938.90' FEET TO C-7 T19N, R6W (GLO. 4959.90')  
MEASURES EAST 2605.82' TO L-7, T19N, R6W (GLO. 2640.00')

APPROVED LAND CORNER  
P.A. 345 of 1990  
Clare County

Chairman Paul A. Loph  
Date 9-26-95


This Corner established in Clare County Remonumentation Program.

See dossier for detailed report.

C. Description of monument for corner and accessories established to perpetuate locating the position of the corner:

M-7: 23-24 SEC. CORNER ON TWP. LINE  
ACCEPTED 1" IRON AS CLARE COUNTY REMONUMENTATION MONUMENT.  
ACCEPTED AS BEST AVAILABLE EVIDENCE OF ACCEPTED POSITION OF CORNER.

WITNESSES:  
N62°W 193.08' - NAIL & TAG IN POWER POLE  
N18°W 102.24' - NAIL & TAG IN LEFT GATE POST  
N13°E 80.41' - NAIL & TAG IN 3RD FENCE POST FROM RIGHT GATE POST  
S48°W 172.08' - NAIL & TAG IN 7" ELM

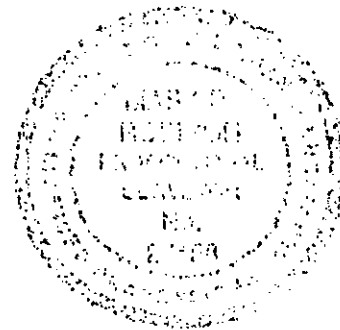

Signed by Mark R. Robison

Date 10-03-95

Surveyor's Michigan License No. 27458