

LAND CORNER RECORDATION CERTIFICATE

FILING REQUIREMENT OF ACT 74, MICH. P.A.1970

FOR CORNERS OF--:	LOCATED IN--:	CORNER CODE NUMBER
1. PUBLIC LAND SURVEY	T. 19 N. R. 6 W.	L-4; M-4
2. PROPERTY CONTROLLING IN SECTION	12, T. 19 N. R. 6 W.	9
3. MISCELLANEOUS PROPERTY IN SECTION	, T. N. S., R. E. W.	
4. LOT NO. _____, RECORDED PLAT _____		
5. PRIVATE CLAIMS _____		

REGISTER OF DEEDS STAMP AND FILING NUMBER

I, Kenneth J. Ostling, do hereby certify that under requirements of P.A. 74, Michigan P.A. of 1970, the corner points mentioned in lines 1 and 2 above were, in a field survey on January 21, 1977, established, re-established, monumented, re-monumented, recovered or restored as expressed below and in conformance with regulations and rules therefore as required in the current manual of survey instructions of the United States Department of the Interior, Bureau of Land Management or by a decree of a court of law. Furthermore, that the corner points mentioned in lines 3, 4 and 5 above were, in a field survey on _____, 19____, found, recovered, restored, established or re-established as expressed below and in conformance with the rules of the Michigan State Board of Registration for Land Surveyors or, by a Decree of a Court of law:

A. Description of original monument and accessories and/or subsequent restoration:

B. Description of corner evidence found and/or method applied in restoring or re-establishing corner:

- L-4 Set at the calculated intersection of the true 1/4 lines, per standard survey procedure.
- M-4 Set by proportionate measurement between section corners. Could find nothing for previous corner.
- 9 Set by standard survey procedure for the subdivision of sections.


C. Description of monument for corner and accessories established to perpetuate locating the position of the corner:

L-4	M-4	9
Set 5/8" hex rod & red-top post	Set 5/8" rerod red-top post	Set 5/8" hex rod & red-top post
4" Balsam N46°E 25.85	7" J. Pine N29°W 33.8	4" Maple S81°E 33.0
4" Maple N31°W 31.20	12" Maple S45°W 25.3	4" Maple N59°E 51.4

SIGNED BY Kenneth J. Ostling

DATE 6/7/77

SURVEYOR'S MICHIGAN REGISTRATION NO. 10068

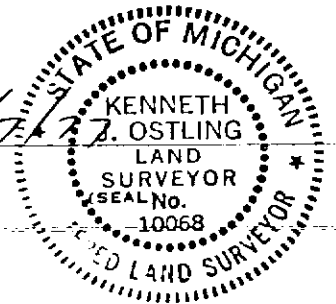

FOR STATE AND UNITED STATES AGENCIES:

SIGNED BY _____ DATE _____

CHIEF OF SURVEY PARTY

APPROVED AND SIGNED BY _____ DATE _____

MICHIGAN REGISTERED LAND SURVEYOR

(SEAL)

SURVEYOR'S MICHIGAN REGISTRATION NO. _____

CLARE COUNTY