

LAND CORNER RECORDATION CERTIFICATE

FILING REQUIREMENT OF ACT 74, MICH. P.A.1970

FOR CORNERS OF--:	LOCATED IN--:	CORNER CODE NUMBER
1. PUBLIC LAND SURVEY	T. 19 N. R. 6 W.	I-2; I-3; J-1
2. PROPERTY CONTROLLING IN SECTION 2	T. 19 N. R. 6 W.	3
3. MISCELLANEOUS PROPERTY IN SECTION	T. S. R. E. W.	
4. LOT NO. _____, RECORDED PLAT _____		
5. PRIVATE CLAIMS _____		

REGISTER OF DEEDS STAMP AND FILING NUMBER

I, Kenneth J. Ostling, do hereby certify that under requirements of P.A. 74, Michigan P.A. of 1970, the corner points mentioned in lines 1 and 2 above were, in a field survey on November 3, 1976, established, re-established, monumented, re-monumented, recovered or restored as expressed below and in conformance with regulations and rules therefore as required in the current manual of survey instructions of the United States Department of the Interior, Bureau of Land Management or by a decree of a court of law. Furthermore, that the corner points mentioned in lines 3, 4 and 5 above were, in a field survey on _____, 19____, found, recovered, restored, established or re-established as expressed below and in conformance with the rules of the Michigan State Board of Registration for Land Surveyors or, by a Decree of a Court of law:

A. Description of original monument and accessories and/or subsequent restoration:

B. Description of corner evidence found and/or method applied in restoring or re-establishing corner:

- I-2 Restored corner from witnesses of record from Gourdie-Fraser survey of 1975 and 1962. Falls in line with old fence east and was used in subdivision of Section 3.
- I-3 Found 1/2" pipe as located and used in previous subdivision of Section 3, by Gourdie-Fraser. Unable to determine origin, but fits corners north and south. Found a 1" iron bar about 45' south, but could not verify its validity, and would depart from other previous surveys.
- J-1 Set by proportionate measurement, MPOL, between section corners. Matches up, generally with old fence east and south. Nothing for previous corner.

3 Set corner by standard survey procedure for the subdivision of sections.

C. Description of monument for corner and accessories established to perpetuate locating the position of the corner:

I-2	I-3	J-1
Set DNR Monument	Set DNR mon. & red-top post	Set DNR mon. & red-top post
6" R. Oak N56°E 55.2	5" R. Pine S62°E 40.55	11" Oak N73°E 40.4
5" J. Pine S71°E 27.45	14" R. Oak N26°W 45.6	4" Oak S04°E 19.0
	Cedar Post East 25'	
		3
		Set 3/8" hex rod & red-top post 20'E
		8" J. Pine N65°E 42.25
		5" Oak N39°W 79.35

SIGNED BY Kenneth Ostling DATE 12/15/76

SURVEYOR'S MICHIGAN REGISTRATION NO. 10068


FOR STATE AND UNITED STATES AGENCIES:

SIGNED BY _____ DATE _____

CHIEF OF SURVEY PARTY

APPROVED AND SIGNED BY _____ DATE _____

MICHIGAN REGISTERED LAND SURVEYOR

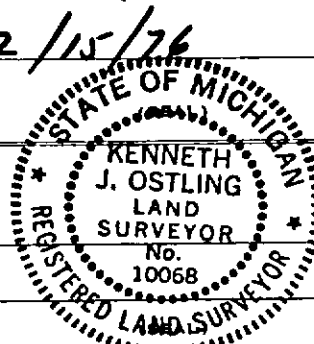

SURVEYOR'S MICHIGAN REGISTRATION NO. _____

CLARE COUNTY