

LAND CORNER RECORDATION CERTIFICATE

FILING REQUIREMENT OF ACT 74, MICH. P.A.1970

FOR CORNERS OF--:	LOCATED IN--:	CORNER CODE NUMBER
1. PUBLIC LAND SURVEY	T. 19 N. R. 6 W.	D-11
2. PROPERTY CONTROLLING IN SECTION	T. N. R. W.	
3. MISCELLANEOUS PROPERTY IN SECTION	T. N. R. E. W.	
4. LOT NO. _____, RECORDED PLAT _____		
5. PRIVATE CLAIMS _____		

REGISTER OF DEEDS STAMP AND FILING NUMBER

I, Carl F. Roser, do hereby certify that under requirements of P.A. 74, Michigan P.A. of 1970, the corner points mentioned in lines 1 and 2 above were, in a field survey on August 15, 1983, established, re-established, monumented, re-monumented, recovered or restored as expressed below and in conformance with regulations and rules therefore as required in the current manual of survey instructions of the United States Department of the Interior, Bureau of Land Management or by a decree of a court of law. Furthermore, that the corner points mentioned in lines 3, 4 and 5 above were, in a field survey on _____, 19____, found, recovered, restored, established or re-established as expressed below and in conformance with the rules of the Michigan State Board of Registration for Land Surveyors or, by a Decree of a Court of law:

A. Description of original monument and accessories and/or subsequent restoration:

B. Description of corner evidence found and/or method applied in restoring or re-establishing corner:

D-11 - Recovered 2" pipe monument by M. Schaaf (Conservation Department Forestry Chief & RLS, now deceased) Aug. 1939 & Apr. 1940. Schaaf notes indicate he had U.S. (G.L.O.) B.T. stump NE, SW B.T. on ground, L.T. stump east & L.T. tip-up west. K. Don Fluke, RLS, fd 2' section of 4" ced post with axed point in swp & raised with 2" pipe in 1975, which fits one A.D. Johnson (Co. surveyor-now deceased) Wit; said corner by Johnson was placed at M. Schaaf 40 ch marker on Schaaf's random line in Oct. 1939. Johnson's corner is S11°39'W, 223.6' from Schaaf's 1/4 corner.

C. Description of monument for corner and accessories established to perpetuate locating the position of the corner:

- D-11
- Fd. 2" x 48" rusty Schaaf pipe; added DNR
 Mon & cedar post
- *12" Cedar N10°W 22.9'
 - *15" Swp oak N15°E 17.1'
 - *11" Cedar N55°E 18.0'
 - 9" Maple Due S 13.6'
- * Schaaf 1939 N.B.T.s.


SIGNED BY Carl F. Roser 01-06-86 DATE _____

SURVEYOR'S MICHIGAN REGISTRATION NO. 12028

FOR STATE AND UNITED STATES AGENCIES:

SIGNED BY _____ DATE _____
CHIEF OF SURVEY PARTY

APPROVED AND SIGNED BY _____ DATE _____
MICHIGAN REGISTERED LAND SURVEYOR

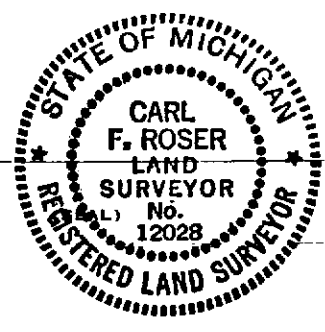

SURVEYOR'S MICHIGAN REGISTRATION NO. _____
 REDDING TWP.
 CLARE COUNTY

MAY PLACE SKETCH ON BACK OR ATTACHED SHEET