

LAND CORNER RECORDATION CERTIFICATE

FILING REQUIREMENT OF ACT 74, MICH. P.A.1970

FOR CORNERS OF--	LOCATED IN--	CORNER CODE NUMBER
1. PUBLIC LAND SURVEY _____	T. 19 N. R. 06 W.	C-1, C-2
2. PROPERTY CONTROLLING IN SECTION _____	6, T. 19 N. R. 06 W.	6, 7
3. MISCELLANEOUS PROPERTY IN SECTION _____	T. _____ N. S. R. _____ E. W.	
4. LOT NO. _____, RECORDED PLAT _____		
5. PRIVATE CLAIMS _____		

REGISTER OF DEEDS STAMP AND FILING NUMBER

I, CARL F. ROSER, do hereby certify that under requirements of P.A. 74, Michigan P.A. of 1970, the corner points mentioned in lines 1 and 2 above were, in a field survey on JANUARY 22, 19 86, established, re-established, monumented, re-monumented, recovered or restored as expressed below and in conformance with regulations and rules therefore as required in the current manual of survey instructions of the United States Department of the Interior, Bureau of Land Management or by a decree of a court of law. Furthermore, that the corner points mentioned in lines 3, 4 and 5 above were, in a field survey on _____, 19____, found, recovered, restored, established or re-established as expressed below and in conformance with the rules of the Michigan State Board of Registration for Land Surveyors or, by a Decree of a Court of law:

C. CONTINUED

6	7
DROVE 5/8" X 40" RE-ROD W/RLS CAP & CED POST W/LOC TAG.	DROVE 6.5' ST FN. POST W/RLS CAP IN SWP. & CED POST W/LOC TAG.
10" MAPLE N70°W 59.0'	4" MAPLE N10°E 27.1'
6" ELM S85°W 24.8'	12" TWIN B. CHERRY N50°E 85.0'
CTR NATURAL GAS WELL #674 N20°E 74.8'	6" MAPLE N75°W 115.9'
	N'LY EDGE OF SWP. NORTH 50'±

B. Description of corner evidence found and/or method applied in restoring or re-establishing corner:

- C-1 FD & ACCEPTED 1" PIPE FOR NE COR OF SEC. 6. CTR OF DIRT RD LOOKING W'LY IS SOUTH 4'±. CTR OF DIRT RD LOOKING N'LY IS EAST 3'±.
- C-2 RE-ESTAB E 1/4 COR OF SEC. 6 ON LINE BETWEEN NE & SE COR'S OF SEC. 6 & AT PRORATED DISTANCE TO U.S. (G.L.O.) RESURVEY OF 1856 (RUN-OUT SEC.).
- 6 ESTAB. SW CORNER OF FRL NE 1/4 OF FRL NE 1/4 OF SEC.6 PER STD. B.L.M. INSTRUCTIONS; PRORATED TO (G.L.O. PLAT (1856 RE-SURVEY), RUN-OUT SECTION.
- 7 ESTAB. SE CORNER OF FRL NE 1/4 OF FRL NE 1/4 OF SEC. 6 PER STD. B.L.M. INSTRUCTIONS; PRORATED TO U.S. (G.L.O. PLAT RUN-OUT SEC).

C. Description of monument for corner and accessories established to perpetuate locating the position of the corner:

C-1	C-2
FD 1" PIPE	SET DNR MON & CED POST
* 5" W. PINE S50°W 54.55'	4" MAPLE N10°W 47.0'
6" R. PINE S25°W 46.66'	6" B. CHERRY N30°E 22.1'
* BELL TEL RISER #351 N15°W 67.6'	6" MAPLE S75°W 43.7'
SET CED. POST W/LOC TAG S. 16.5'	N'LY END OF OLD OVER-NORTH 40'±
	GROW N-S GRADE
	CTR OF OLD GRADE EAST 3'±


SIGNED BY Carl F. Roser 01-27-86 DATE _____

SURVEYOR'S MICHIGAN REGISTRATION NO. 12028

FOR STATE AND UNITED STATES AGENCIES:

SIGNED BY _____ DATE _____

APPROVED AND SIGNED BY _____ DATE _____

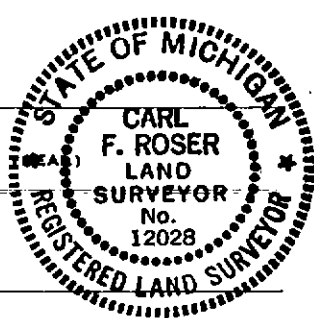

SURVEYOR'S MICHIGAN REGISTRATION NO. _____

(SEAL)
REDDING TWP.
CLARE COUNTY