

LAND CORNER RECORDATION CERTIFICATE

FILING REQUIREMENT OF ACT 74, MICH. P.A.1970

FOR CORNERS OF--	LOCATED IN--	CORNER CODE NUMBER
1. PUBLIC LAND SURVEY _____	T. 19 ^{N.} / _{S.} , R. 6 ^{E.} / _{W.}	C-10;
2. PROPERTY CONTROLLING IN SECTION 30 _____	T. 19 ^{N.} / _{S.} , R. 6 ^{E.} / _{W.}	7
3. MISCELLANEOUS PROPERTY IN SECTION _____	T. _____ ^{N.} / _{S.} , R. _____ ^{E.} / _{W.}	
4. LOT NO. _____, RECORDED PLAT _____		
5. PRIVATE CLAIMS _____		

REGISTER OF DEEDS STAMP AND FILING NUMBER

I, Carl F. Roser, do hereby certify that under requirements of P.A. 74, Michigan P.A. of 1970, the corner points mentioned in lines 1 and 2 above were, in a field survey on 2/6; 2/25, 1985, established, re-established, monumented, re-monumented, recovered or restored as expressed below and in conformance with regulations and rules therefore as required in the current manual of survey instructions of the United States Department of the Interior, Bureau of Land Management or by a decree of a court of law. Furthermore, that the corner points mentioned in lines 3, 4 and 5 above were, in a field survey on _____, 19____, found, recovered, restored, established or re-established as expressed below and in conformance with the rules of the Michigan State Board of Registration for Land Surveyors or, by a Decree of a Court of law:

A. Description of original monument and accessories and/or subsequent restoration:

B. Description of corner evidence found and/or method applied in restoring or re-establishing corner:

C-10 - Fd and accepted 1/2" rod with RLS cap (Paul Lapham) for E 1/4 cor of Sec. 30; 0.32 feet east of 2" pipe by M. Schaaf (drove flush). Schaaf notes (April 1940) indicate he had Milton Nye's (Apr 1857) resurvey correction to Francis Coleman's 1856 resurvey corner.

7 - Fd rod by RLS, Paul Lapham for N1/8 cor on E line of Sec. 30

C. Description of monument for corner and accessories established to perpetuate locating the position of the corner:

	<u>C-10</u>		<u>7</u>	
Fd 1/2" rerod w/RLS cap; added DNR Mon & ced post w/loc tag; 10/2/84 drove MS pipe flush			Fd rod w/RLS cap #9433; added ced post w/loc tag	
9" oak	N75°W	15.66'	7" Maple	N40°W 17.3'
16" oak	N40°E	40.58'	12" Maple	N70°E 15.4'
15" oak stub	Due S	51.17'	12" Maple (twin)	S45°E 13.1'
17" oak	S60°W	47.38'		

SIGNED BY Carl F. Roser 01-06-86 DATE _____

SURVEYOR'S MICHIGAN REGISTRATION NO. 12028

FOR STATE AND UNITED STATES AGENCIES:


SIGNED BY _____ DATE _____

CHIEF OF SURVEY PARTY

APPROVED AND SIGNED BY _____ DATE _____

MICHIGAN REGISTERED LAND SURVEYOR

(SEAL)

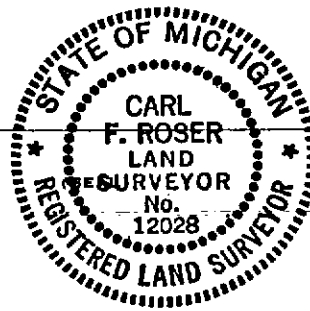

SURVEYOR'S MICHIGAN REGISTRATION NO. _____

REDDING TWP
CLARE COUNTY

Reproduced by the State of Michigan