

LAND CORNER RECORDATION CERTIFICATE

FILING REQUIREMENT OF ACT 74, MICH. P.A.1970

FOR CORNERS OF--:	LOCATED IN--:	CORNER CODE NUMBER
1. PUBLIC LAND SURVEY _____	T. 19 ^{N.} / _{S.} , R. 6 ^{E.} / _{W.}	D-12; D-13;
2. PROPERTY CONTROLLING IN SECTION 32 _____	T. 19 ^{N.} / _{S.} , R. 6 ^{E.} / _{W.}	5
3. MISCELLANEOUS PROPERTY IN SECTION _____	T. _____ ^{N.} / _{S.} , R. _____ ^{E.} / _{W.}	_____
4. LOT NO. _____, RECORDED PLAT _____		
5. PRIVATE CLAIMS _____		

REGISTER OF DEEDS STAMP AND FILING NUMBER

I, Carl F. Roser, do hereby certify that under requirements of P.A. 74, Michigan P.A. of 1970, the corner points mentioned in lines 1 and 2 above were, in a field survey on February 6, 1985, established, re-established, monumented, re-monumented, recovered or restored as expressed below and in conformance with regulations and rules therefore as required in the current manual of survey instructions of the United States Department of the Interior, Bureau of Land Management or by a decree of a court of law. Furthermore, that the corner points mentioned in lines 3, 4 and 5 above were, in a field survey on _____, 19____, found, recovered, restored, established or re-established as expressed below and in conformance with the rules of the Michigan State Board of Registration for Land Surveyors or, by a Decree of a Court of law:

C. CONTINUED:

~~A. Description of original monument and accessories and/or subsequent restoration:~~

5

Drove 5/8" x 34" ⁵rerod w/RLS cap & set ced post w/loc tag

7" B Oak	N25°W	11.4'
4" B Oak	S50°E	5.8'
5" Oak	S55°W	24.7'
6" B. Cherry	S05°E	20.4'
ctr N-S trail	Due E	472'

B. Description of corner evidence found and/or method applied in restoring or re-establishing corner:

D-12 - Estab. ctr of S-32 at intersection of $\frac{1}{4}$ lines.
D-13 - Fd & Accepted $\frac{1}{2}$ " rod with Paul Lapham, RLS cap, in old 3" clay tile. Arthur Johnson call for tile 33' south of fn corner.
5 - Estab. NW cor of SW $\frac{1}{4}$ of NE $\frac{1}{4}$ of S-32 per std B.L.M. instructions. N-S smooth wire is west 38'.

C. Description of monument for corner and accessories established to perpetuate locating the position of the corner:

<u>D-12</u>	<u>D-13</u>
Drove 8' steel fn post w/RLS cap & set ced post w/loc tag	Fd $\frac{1}{2}$ " iron rod w/RLS cap in 3" clay tile (flush) added ced post w/loc tag
5" Tamarack N55°W 9.3'	4" Balsam N80°E 15.0'
2" W Birch N25°E 9.7'	4" R Pine S10°E 20.00'
6" Cedar S50°E 28.9'	6" Maple in clump 5 N65°W 11.97'
4" Balsam S30°E 30.8'	old fn cor, fns E&N N05°E 33'
	Fd 1 $\frac{1}{2}$ " pipe S 33.60'

SIGNED BY Carl F. Roser 01-06-86 DATE _____

SURVEYOR'S MICHIGAN REGISTRATION NO. 12028


FOR STATE AND UNITED STATES AGENCIES:

SIGNED BY _____ DATE _____

CHIEF OF SURVEY PARTY

APPROVED AND SIGNED BY _____ DATE _____

MICHIGAN REGISTERED LAND SURVEYOR

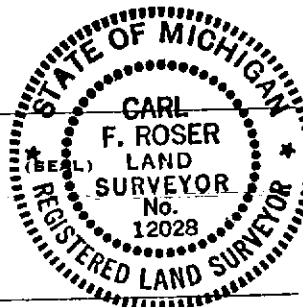

(SEAL)

SURVEYOR'S MICHIGAN REGISTRATION NO. _____ REDDING TWP.
 CLARE COUNTY

Reproduced by the State of Michigan