

# LAND CORNER RECORDATION CERTIFICATE

## FILING REQUIREMENT OF ACT 74, MICH. P.A. 1970

FOR CORNERS OF--:	LOCATED IN--:	CORNER CODE NUMBER
1. PUBLIC LAND SURVEY _____ T. _____ N. <input checked="" type="checkbox"/> S. R. _____ E. <input checked="" type="checkbox"/> W.		
2. PROPERTY CONTROLLING IN SECTION <u>32</u> T. <u>19</u> N. <input checked="" type="checkbox"/> S. R. <u>6</u> E. <input checked="" type="checkbox"/> W.		<u>6;9;12</u>
3. MISCELLANEOUS PROPERTY IN SECTION _____ T. _____ N. _____ S. R. _____ E. _____ W.		
4. LOT NO. _____, RECORDED PLAT _____		
5. PRIVATE CLAIMS _____		

REGISTER OF DEEDS STAMP AND FILING NUMBER

I, Carl F. Roser, do hereby certify that under requirements of P.A. 74, Michigan P.A. of 1970, the corner points mentioned in lines 1 and 2 above were, in a field survey on February 6, 1985, established, re-established, monumented, re-monumented, recovered or restored as expressed below and in conformance with regulations and rules therefore as required in the current manual of survey instructions of the United States Department of the Interior, Bureau of Land Management or by a decree of a court of law. Furthermore, that the corner points mentioned in lines 3, 4 and 5 above were, in a field survey on \_\_\_\_\_, 19\_\_\_\_, found, recovered, restored, established or re-established as expressed below and in conformance with the rules of the Michigan State Board of Registration for Land Surveyors or, by a Decree of a Court of law:

C. CONTINUED:  
~~A. Description of original monument and/or accessory and/or subsequent restoration:~~

- 12
- Set 5/8" x 34" rerod w/RLS cap & ced post w/loc tag
- |                     |       |       |
|---------------------|-------|-------|
| 2" Tamarack         | N35°W | 16.7' |
| 7" Maple            | N40°E | 6.7'  |
| 3" Tamarack         | S60°E | 28.1' |
| 4" B Oak            | S30°W | 5.4'  |
| Old fn cor (fn E&S) | S60°E | 32'   |
| Ctr N-S trail       | Due E | 283'  |


- B. Description of corner evidence found and/or method applied in restoring or re-establishing corner:
- 6 - Estab. ctr of NE $\frac{1}{4}$  of Sec. 32 per std B.L.M. instructions.
  - 9 - Estab. SE cor of SW $\frac{1}{4}$  of NE $\frac{1}{4}$  of Sec. 32 per Std B.L.M. instructions.
  - 12 - Estab. SW cor of NW $\frac{1}{4}$  of SE $\frac{1}{4}$  of S-32 per std B.L.M. instructions.

C. Description of monument for corner and accessories established to perpetuate locating the position of the corner:

- |   |        
|---|--------|-------|-----|--------|-------|------|--------|-------|------|--|--------|-------|-------|-----------------|-------|-------|--------|-------|-------|
| <p style="text-align: center;"><u>6</u></p> <p>Drove 5/8" x 34" rerod w/RLS cap &amp; ced post w/loc tag</p> <table style="width: 100%;"> <tr> <td>2" Oak</td> <td>N70°W</td> <td>9.9</td> </tr> <tr> <td>3" Oak</td> <td>N40°E</td> <td>25.3</td> </tr> <tr> <td>9" Oak</td> <td>S05°W</td> <td>57.1</td> </tr> </table> | 2" Oak | N70°W | 9.9 | 3" Oak | N40°E | 25.3 | 9" Oak | S05°W | 57.1 | <p style="text-align: center;"><u>9</u></p> <p>Drove 5/8" x 34" rerod w/RLS cap set ced post w/loc tag</p> <table style="width: 100%;"> <tr> <td>5" Oak</td> <td>N70°W</td> <td>42.0'</td> </tr> <tr> <td>10" N Pine stub</td> <td>N70°E</td> <td>14.4'</td> </tr> <tr> <td>5" Oak</td> <td>S60°W</td> <td>29.1'</td> </tr> </table> | 5" Oak | N70°W | 42.0' | 10" N Pine stub | N70°E | 14.4' | 5" Oak | S60°W | 29.1' |
| 2" Oak  | N70°W  | 9.9   |     |        |       |      |        |       |      |  |        |       |       |                 |       |       |        |       |       |
| 3" Oak  | N40°E  | 25.3  |     |        |       |      |        |       |      |  |        |       |       |                 |       |       |        |       |       |
| 9" Oak  | S05°W  | 57.1  |     |        |       |      |        |       |      |  |        |       |       |                 |       |       |        |       |       |
| 5" Oak  | N70°W  | 42.0' |     |        |       |      |        |       |      |  |        |       |       |                 |       |       |        |       |       |
| 10" N Pine stub   | N70°E  | 14.4' |     |        |       |      |        |       |      |  |        |       |       |                 |       |       |        |       |       |
| 5" Oak  | S60°W  | 29.1' |     |        |       |      |        |       |      |  |        |       |       |                 |       |       |        |       |       |

SIGNED BY Carl F. Roser 01-06-86 DATE \_\_\_\_\_

SURVEYOR'S MICHIGAN REGISTRATION NO. 12028

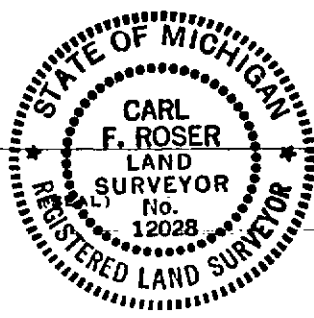

FOR STATE AND UNITED STATES AGENCIES:

SIGNED BY \_\_\_\_\_ DATE \_\_\_\_\_  
CHIEF OF SURVEY PARTY

APPROVED AND SIGNED BY \_\_\_\_\_ DATE \_\_\_\_\_  
MICHIGAN REGISTERED LAND SURVEYOR

SURVEYOR'S MICHIGAN REGISTRATION NO. \_\_\_\_\_ (SEAL)  
 REDDING TWP.  
 CLARE COUNTY

Reproduced by the State of Michigan