

LAND CORNER RECORDATION CERTIFICATE

FILING REQUIREMENT OF ACT 74, MICH. P.A.1970

FOR CORNERS OF--	LOCATED IN--	CORNER CODE NUMBER	
1. PUBLIC LAND SURVEY	T. 19 N. 6 R. 6 W.	C-9; A-6	
2. PROPERTY CONTROLLING IN SECTION	19 T. 19 N. 6 R. 6 W.	16	
3. MISCELLANEOUS PROPERTY IN SECTION	T. N. S. R. E. W.		
4. LOT NO. _____, RECORDED PLAT _____			
5. PRIVATE CLAIMS _____			

REGISTER OF DEEDS STAMP AND FILING NUMBER

I, Carl F. Roser, do hereby certify that under requirements of P.A. 74, Michigan P.A. of 1970, the corner points mentioned in lines 1 and 2 above were, in a field survey on February 6, 1985, established, re-established, monumented, re-monumented, recovered or restored as expressed below and in conformance with regulations and rules therefore as required in the current manual of survey instructions of the United States Department of the Interior, Bureau of Land Management or by a decree of a court of law. Furthermore, that the corner points mentioned in lines 3, 4 and 5 above were, in a field survey on _____, 19____, found, recovered, restored, established or re-established as expressed below and in conformance with the rules of the Michigan State Board of Registration for Land Surveyors or, by a Decree of a Court of law:

C-Continued
~~A. Description of original monument and accessories and or subsequent restoration~~

- A-6
- Fd 1" x 28" galv. pipe & 3-3" clay tiles;
 - added DNR Mon
 - *16" B Oak N25°E 20.58'
 - *8" R Pine S75°E 21.91'
 - *14" B Oak S65°W 16.66'
 - Set Ced post
 - w/loc. tag Due W 5'
 - * MDOT wit

B. Description of corner evidence found and/or method applied in restoring or re-establishing corner:

- C-9 - Fd & accepted old rusty 1 3/4" pipe for SE cor. of Section 19. Pipe believed to be by Marcus Schaaf, Aug. 1939. Schaafs notes indicate he had Milton Nye's Resurvey corner (Apr. 1857) 5.70½ chains north of Francis Coleman's 1856 Resurvey corner.
- 16 - Fd & accepted 1/2" rod by RLS John Sedgman, for E 1/8 cor. on south line of Sec. 19 (SW Corner of frl. SE½ of frl. SE½ - 30.04 acres per 1856-1857 G.L.O. dependent resurvey).
- A-6 - Fd. 1" pipe & 3 clay tiles that fit MDOT Wits, M. Schaaf wit. and U.S.B.T. (Y. Pine Stump) remains, N10°E.

C. Description of monument for corner and accessories established to perpetuate locating the position of the corner:

- | | |
|---|---|
| <p style="text-align: center;"><u>C-9</u></p> <p>Fd old 1 3/4" pipe; added DNR mon & ced post</p> <ul style="list-style-type: none"> 6" Balsam N30°E 19.26' 8" Black Cherry N80°E 23.68' 12" Maple clump 3 S75°E 26.40' 5" Black Cherry S35°W 8.00' | <p style="text-align: center;"><u>16</u></p> <p>Fd ½" rod w/RLS cap; added cedar post w/loc tag</p> <ul style="list-style-type: none"> 6" Maple clump 2 S70°E 4.9' 4" Ash N25°E 34.7' 6" Ash S80°W 25.8' Ctr Creek Due W 131' |
|---|---|

SIGNED BY Carl F. Roser 01-06-86 DATE _____

SURVEYOR'S MICHIGAN REGISTRATION NO. 12028


FOR STATE AND UNITED STATES AGENCIES:

SIGNED BY _____ DATE _____

CHIEF OF SURVEY PARTY

APPROVED AND SIGNED BY _____ DATE _____

MICHIGAN REGISTERED LAND SURVEYOR

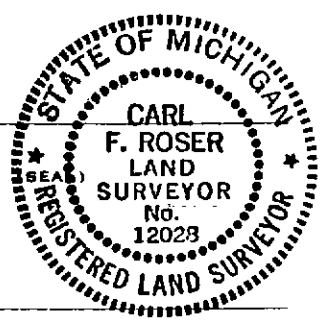

(SEAL)
 REDDING TWP
 CLARE COUNTY

SURVEYOR'S MICHIGAN REGISTRATION NO. _____

Reproduced by the State of Michigan