


LAND CORNER RECORDATION CERTIFICATE

Filing Requirement of Act 74, Mich. PA 1970

For Corners In:			
Clare	Located In	Corner Code #	
(County)			
1. Public Land Survey	T 19N R 6W	E7	
	T	R	
2. Property Controlling in Section	S T	R	
	S T	R	
3. Miscellaneous Property in Section	S T	R	
	S T	R	
4. Lot No: _____	Recorded Plat: _____		
5. Private Claims: _____			

Register of Deeds Stamp & File Number

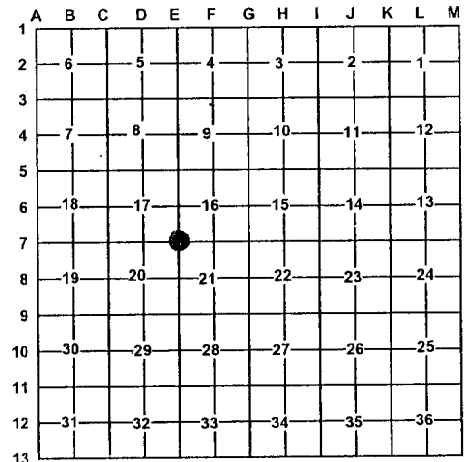

I, Craig W. McVean, in a field survey on Oct. 15, 2008 do hereby state that under requirements of PA 74, Michigan PA of 1970, the corner points mentioned in lines 1 and 2 above were in conformance with regulations and rules therefore as required in the current manual of survey instructions of the United States Department of the Interior, Bureau of Land Management or by a decree of a Court of Law and/or that the corner points mentioned in lines 3, 4 and 5 above were in conformance with the rules of the Michigan Board of Land Surveyors or by a Decree of a Court of Law; established, re-established, monumented, recovered, found as expressed below:

NOTE: Not more than 2 corners, all in the same town and range, may be recorded on this certificate.

A. Description of original monument and accessories and/or subsequent restoration:

E7 – 1856 – Set Post – F. Coleman

- 1) 8" Cedar N20°E 21 L.
- 2) 7" Hemlock S36°W 11 L.
- Old corner 4 Chs N & 212 L. E. defaced
- Cedar 13" N39°W 20 L.
- Cedar 8" S38°E 22 L.
- 1911 – CSR – L. 2, p. 9 – A. D. Johnson Cedar Stake
- 3) Pine 16" N70°W 38
- 4) Cedar 16" S39°W 25 ½
- 1940 – M. Schaaf – Fd. NE Cedar Stp. in place and SW hole. Very definite both exact. About 25 L. W. of old road.
- 5) Wh. P. Stp. 20" S19°W 17
- 6) Wh. P. Stp. 28" N61°W 122 ½
- 7) Cedar Stp. 18" N33°E 116

Measured N 4 Chs. and 212 L. E. and found Old Corner – Both holes exact – 3 new BTs made.
 - 1986 – LCRC L. 1, p. 741 – C. F. Roser – Fd. old 2" pipe per M. Schaaf. Add Ced. Post w/ loc. tag.
 8) 14" Maple N50°E 12.5'; 9) 16" B. Cherry S20°E 18.9';
 10) 9" Maple S40°W 21.7'; 11) 6" x 60" pipe with conc. gate post E. 19.9'; Ctr N-S trail E 27'
 - 1998 – Remon. LCRC #270-98 – M. R. Robison – Fd. 2" pipe and three 1940 wits. and all 1986 Witnesses. Set 5/8" x 36" Clare Co. Remonumentation Cap marked PS#27458. 8) N50°E 12.50' Nail and tag 18" Maple; 9) S20°E 18.90' nail & tag 20" B. Cherry; 10) S40°W 21.70' nail & tag 13" Maple; 11) East 19.90' - 6" x 60" Pipe w/ conc. Gate post; East 27' Center of N-S Trail

B. Description of corner evidence found and/or method applied in restoring or re-establishing corner:

E7 – Section Corner common to Sections 16, 17, 20, & 21 – Fd. 3 ¼" Clare Co. Remon Alum. Cap per LCRC #270-98. Center of N-S 2-track is 27' East. The GLO swamp calls indicate this corner should be 2 Chains South of N. Edge of Swamp but corner is 22' ± N. of the N. Edge of Swamp. Witnesses #1 through 7 are gone; #8 – OK, #9 – Fd. stp.; #10 – Dead; #11 – OK. Clare Co. Monument accepted as a careful and faithful perpetuation of the position of the original corner.

C. Description of monument for corner and accessories established to perpetuate locating the position of the corner:

E7 – Add Section numbers Stamping to Fd. 3 ¼" Alum. Cap.
 NE 0.4' to fd. Cedar post
 West 1' to set Blue Carsonite Post
 N21°W 36.96' to set N & T in E. side 12" Tamarack scribed 'XBT'
 S79°W 27.34' to set N & T in N. side 13" Oak scribed 'XBT'
 S3°W 15.77' to set N & T in W. side 7" R. Maple Clp. – 5
 N48°E 12.40' to set N & T at fd. nail in NW side 20" R. Maple (#8)
 East 19.77 to chiseled 'X' (up 2.5') on 6" x 60" steel gate post with concrete (#11)



Signed by: Craig W. McVean
 Surveyor's Michigan License No.: 39088

Date: 5/26/2009