



**LAND CORNER RECORDATION CERTIFICATE**  
Filing Requirement of Act 74, Mich. PA 1970

For Corners In:			
Clare	Located In	Corner Code #	
(County)			
1. Public Land Survey	T <u>19N</u> R <u>6W</u>	<u>MC-47</u>	
	T _____ R _____	_____	
2. Property Controlling in Section	S _____ T _____ R _____	_____	
	S _____ T _____ R _____	_____	
3. Miscellaneous Property in Section	S _____ T _____ R _____	_____	
	S _____ T _____ R _____	_____	
4. Lot No: _____	Recorded Plat: _____		
5. Private Claims: _____			

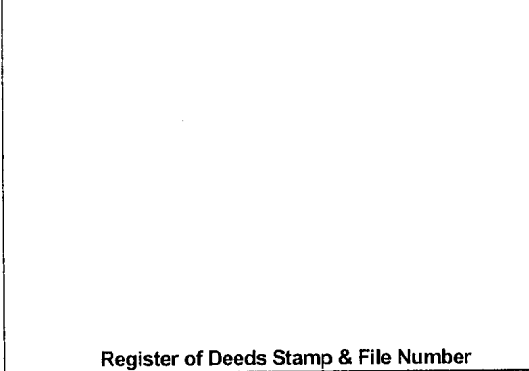

I, Craig W. McVean, in a field survey on Sept. 25, 2008 do hereby state that under requirements of PA 74, Michigan PA of 1970, the corner points mentioned in lines 1 and 2 above were in conformance with regulations and rules therefore as required in the current manual of survey instructions of the United States Department of the Interior, Bureau of Land Management or by a decree of a Court of Law and/or that the corner points mentioned in lines 3, 4 and 5 above were in conformance with the rules of the Michigan Board of Land Surveyors or by a Decree of a Court of Law; established, re-established, monumented, recovered, found as expressed below:

**NOTE: Not more than 2 corners, all in the same town and range, may be recorded on this certificate.**

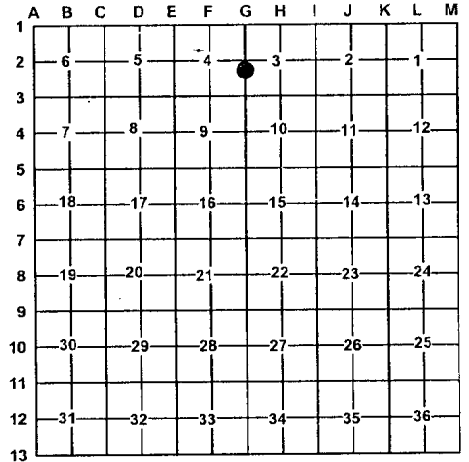

A. Description of original monument and accessories and/or subsequent restoration:

MC-47 – **1856** – F. Coleman – GLO Resurvey  
S0°3'E Corr. Between Sec. 3 & 4  
44.52 Intersect Muskegon River C ESE &  
Set Meander Post  
1) Maple 14" N9½°W 31 L.  
2) W. Ash 10" N57°E 10 L.

B. Description of corner evidence found and/or method applied in restoring or re-establishing corner:

MC-47 – Meander Corner #47 per GLO plat on left bank of Muskegon River 44.52 Ch. South of 'G1' on line between Sections 3 & 4 – No GLO evidence found. Set 2" Alum. Cap on 5/8" x 34" rebar by single proportion to GLO on line between 'G1' and 'G3'. Position falls on old apparent river bank-Course S70°E - with large hardwoods along. River is migrating and eroding to South. Edge of apparent old bank is South 11'±. Existing edge of river is South 58'±. 2" Alum. Cap accepted as a careful and faithful reestablishment of the position of the original corner.

C. Description of monument for corner and accessories established to perpetuate locating the position of the corner:

MC-47 – Stamped 2" Aluminum Cap on 5/8" x 34" rebar  
Set Blue Carsonite Post with loc. tag 1' W.  
N9°E 19.32' to set N & T in W. side 13" R. Maple  
S85°E 23.54' to set N & T in S. side Tri. 18" R. Maple  
N80°W 29.26' to set N & T in S. side 27" R. Maple  
N23°W 56.02' to set N & T in W. side Tw. 10" W. Oak  
N88°31'W 19.46' to Fd. ½" CIR # 9433  
N0°42'58"E 394.31' (396' – GLO) to 'G2' – DNR Monument



Signed by: Craig W. McVean Date: 5/26/2009  
Surveyor's Michigan License No.: 39088