

LAND CORNER RECORDATION CERTIFICATE
 Filing Requirement of Act 74, Mich. PA 1970

For Corners In: Clare Located In _____ Corner Code # _____
 (County)

1. Public Land Survey T _____ R _____
 T _____ R _____


2. Property Controlling in Section S 3 T 19N R 6W 9
 S 3 T 19N R 6W 15

3. Miscellaneous Property in Section S _____ T _____ R _____
 S _____ T _____ R _____

4. Lot No: _____ Recorded Plat: _____

5. Private Claims: _____

Register of Deeds Stamp & File Number

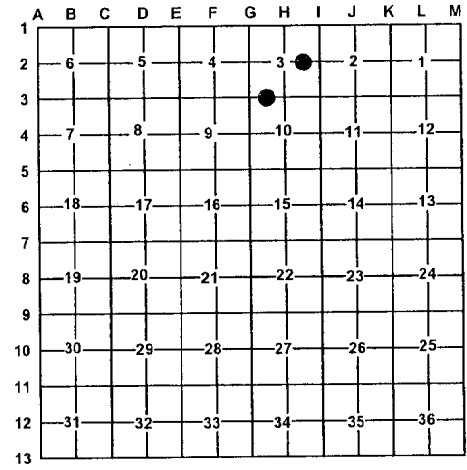

I, Craig W. McVean, in a field survey on Sept. 10, 2008 do hereby state that under requirements of PA 74, Michigan PA of 1970, the corner points mentioned in lines 1 and 2 above were in conformance with regulations and rules therefore as required in the current manual of survey instructions of the United States Department of the Interior, Bureau of Land Management or by a decree of a Court of Law and/or that the corner points mentioned in lines 3, 4 and 5 above were in conformance with the rules of the Michigan Board of Land Surveyors or by a Decree of a Court of Law; established, re-established, monumented, recovered, found as expressed below:

NOTE: Not more than 2 corners, all in the same town and range, may be recorded on this certificate.

A. Description of original monument and accessories and/or subsequent restoration:

9 - None

15 - 1975 - Rec. Survey - L. 2, p. 48 - G. F. DeLaMater - iron set



B. Description of corner evidence found and/or method applied in restoring or re-establishing corner:

9 - CE 1/16 Cor., Sec. 3 - Set stamped 2" Alum. Cap on 5/8" x 34" rebar per Standard BLM procedure.

15 - W 1/16 Corner common to Sec. 3 & 10 - Set stamped 2" Alum. Cap on 5/8" x 34" rebar per Standard BLM procedure in swamp. Edge of Swamp is 93'±E. Could find no evidence of DeLaMater position but by calculation it would be S18°30'W 51.8' from '15'.

C. Description of monument for corner and accessories established to perpetuate locating the position of the corner:

9 - Stamped 2" Aluminum Cap on 5/8" x 34" rebar. Set Blue Carsonite Post with loc. tag 1' SE. N16°E 46.20' to set N & T in W. side 7" W. Pine S75°E 72.36' to set N & T in S. side 5" W. Pine S46°W 56.94' to set N & T in S. side 11" R. Oak N48°W 73.22' to set N & T in SW side 8" W. Pine

15 - Stamped 2" Aluminum Cap on 5/8" x 34" rebar. Set Blue Carsonite Post with loc. tag 1' E N68°E 25.00' to set N & T in S. side 12" R. Maple S33°E 17.96' to set N & T in E. side 11" Cedar S75°W 14.98' to set N & T in N. side 8" R. Maple N21°W 9.93' to set N & T in W. side 3" Fir

Signed by: Craig W. McVean Date: 5/26/2008
 Surveyor's Michigan License No.: 39088