

LAND CORNER RECORDATION CERTIFICATE

Filing Requirement of Act 74, Mich. PA 1970

For Corners In:
Clare Located In _____ Corner Code # _____
 (County)

- | | | | | | |
|--------------------------------------|------------|--------------|-------------|--|-----------|
| 1. Public Land Survey | T _____ | R _____ | | | |
| | T _____ | R _____ | | | |
| 2. Property Controlling in Section | S <u>9</u> | T <u>19N</u> | R <u>6W</u> | | <u>13</u> |
| | S <u>9</u> | T <u>19N</u> | R <u>6W</u> | | <u>15</u> |
| 3. Miscellaneous Property in Section | S _____ | T _____ | R _____ | | |
| | S _____ | T _____ | R _____ | | |


Register of Deeds Stamp & File Number

4. Lot No: _____ Recorded Plat: _____

5. Private Claims: _____

I, Craig W. McVean, in a field survey on Oct. 22, 2008 do hereby state that under requirements of PA 74, Michigan PA of 1970, the corner points mentioned in lines 1 and 2 above were in conformance with regulations and rules therefore as required in the current manual of survey instructions of the United States Department of the Interior, Bureau of Land Management or by a decree of a Court of Law and/or that the corner points mentioned in lines 3, 4 and 5 above were in conformance with the rules of the Michigan Board of Land Surveyors or by a Decree of a Court of Law; established, re-established, monumented, recovered, found as expressed below:

NOTE: Not more than 2 corners, all in the same town and range, may be recorded on this certificate.

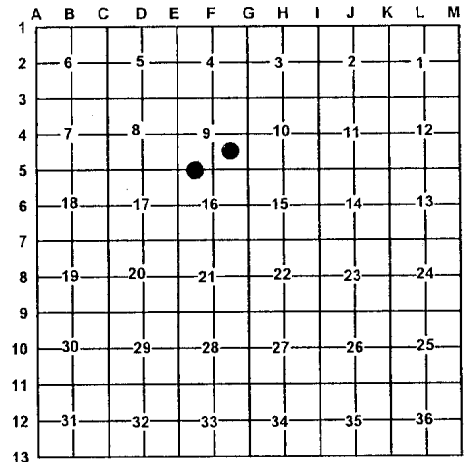

A. Description of original monument and accessories and/or subsequent restoration:

13 - None



15 - 1911 - CSR - L. 2, p. 8 - A. D. Johnson
 1) W. Pine 30° N48°E 152
 2) W. Pine 30° S54°E 212

B. Description of corner evidence found and/or method applied in restoring or re-establishing corner:

13 - SE 1/16 Corner, Sec. 9, T19N, R6W - Set Stamped 2" Aluminum Cap on 5/8" x 34" rebar midway and on line between calc. position at Cor. '9' (Falls in River) and calc. position of Cor. '16'. Felt this was best solution due to deflection on S. Section line at Manistee River Meander Corner near 'Cor. '16'. South 87' to N. Bank of side river channel.

15 - W 1/16 Corner common to Sec. 9 & 16 - No evidence of Johnson BT's. Found 1/2" x 18" smooth iron rod with cap #19003. Corner of wolven wire fence remains N & W is S14°28'E 27.4'. Also fences go E and S from found 1/2" CIR on other side of N & W fence. 1/2" CIR accepted as the best available evidence of the position of the corner.

C. Description of monument for corner and accessories established to perpetuate locating the position of the corner:

13 - Stamped 2" Aluminum Cap on 5/8" x 34" rebar Set Blue Carsonite Post 1' W.
 S47°W 38.18' to set N & T in NW side 31" R. Maple
 N83°W 77.29' to set N & T in N. side 10" Cedar
 N45°W 18.37' to set N & T in NE side Tw. 5" & 7" Basswood
 N7°E 25.09' to set N & T in W. side 11" W. Oak

15 - Replaced 1/2" x 18" CIR # 19003 with stamped 2" Alum. Cap on 5/8" x 34" rebar.
 S25°E 0.36' to face of 5" x 6" tall iron guard post
 S50°W 27.64' to set N & T in SE side 5" Cherry
 N41°W 22.83' to set N & T in SW side 9" J. Pine
 N67°E 13.15' to set N & T in S. side 10" J. Pine
 N6°E 76.49' to set N & T in W. side 5" J. Pine
 Set Blue Carsonite Post 1' NE

Signed by: _____

Craig W. McVean

Date: _____

5/26/2009

Surveyor's Michigan License No.: _____

39088