

LAND CORNER RECORDATION CERTIFICATE

Filing Requirement of Act 74, Mich. PA 1970

For Corners In:
Clare
 (County)

		Located In		Corner Code #
1. Public Land Survey	T	_____	R	_____
	T	_____	R	_____
2. Property Controlling in Section	S <u>11</u>	T <u>19N</u>	R <u>6W</u>	<u>15</u>
	S <u>11</u>	T <u>19N</u>	R <u>6W</u>	<u>16</u>
3. Miscellaneous Property in Section	S _____	T _____	R _____	_____
	S _____	T _____	R _____	_____


4. Lot No: _____ Recorded Plat: _____

5. Private Claims: _____

I, Craig W. McVean, in a field survey on Oct. 28, 2008 do hereby state that under requirements of PA 74, Michigan PA of 1970, the corner points mentioned in lines 1 and 2 above were in conformance with regulations and rules therefore as required in the current manual of survey instructions of the United States Department of the Interior, Bureau of Land Management or by a decree of a Court of Law and/or that the corner points mentioned in lines 3, 4 and 5 above were in conformance with the rules of the Michigan Board of Land Surveyors or by a Decree of a Court of Law; established, re-established, monumented, recovered, found as expressed below:

NOTE: Not more than 2 corners, all in the same town and range, may be recorded on this certificate.

Register of Deeds Stamp & File Number

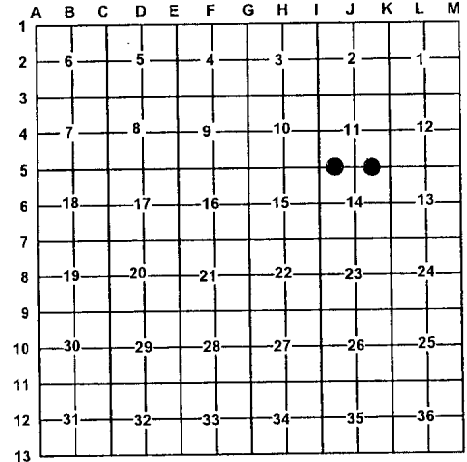

A. Description of original monument and accessories and/or subsequent restoration:

15 - None

16 - None



B. Description of corner evidence found and/or method applied in restoring or re-establishing corner:

15 - W 1/16 Corner common to Sec. 11 & 14 - Set Stamped 2" Aluminum cap on 5/8" x 34" rebar per Standard BLM procedure. Falls in Cedar swamp. Edge of swamp is 15'± 20' East.

16 - E 1/16 Corner common to Sec. 11 & 14 - Set stamped 2" Aluminum Cap on 5/8" x 34" rebar per Standard BLM Procedure. Falls in remains of down E-W fence. Corner of old fence E, W & N is 40'± East.

C. Description of monument for corner and accessories established to perpetuate locating the position of the corner:

15 - Stamped 2" Aluminum Cap on 5/8" x 34" rebar
 N60°W 42.88' to set N & T in NE side 10" Cedar
 N25°W 29.75' to set N & T in W. Side 11" R. Maple
 N47°E 19.71' to set N & T in SE side 7" R. Maple
 scribed 'XBT'
 N50°03'E 39.75' to Top Fd. 3/4" iron pipe - up 2'
 East 72.35' to set N & T in N. side 5" R. Maple scribed 'XBT'
 Set Blue Carsonite Post with loc. Tag 1' NW

16 - Stamped 2" Alum. Cap on 5/8" x 34" rebar
 S81°W 30.69' to set N & T in S. side 20" W. Pine
 N7°E 57.71' to set N & T in E. side 3" W. Pine
 N51°E 24.55' to set N & T in NW side Tw. 16" & 11" R. Maple
 S42°E 9.80' to set N & T in SW side 10" R. Maple
 Set Blue Carsonite Post with loc. Tag 1' NE

Signed by: Craig W. McVean
 Surveyor's Michigan License No.: 39088

Date: 5/26/2009