


LAND CORNER RECORDATION CERTIFICATE

Filing Requirement of Act 74, Mich. PA 1970

REMONUMENTATION

For Corners In: Clare (County)	Located In	Corner Code #
1. Public Land Survey	T 19N R 6W	#3
2. Property Controlling in Section	S T R	
3. Miscellaneous Property in Section	S T R	
4. Lot No: _____	Recorded Plat: _____	
5. Private Claims: _____		

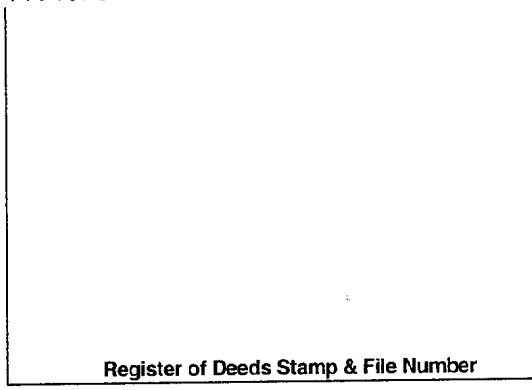

I, Craig W. McVean, in a field survey on Sept. 25, 2008 do hereby state that under requirements of PA 74, Michigan PA of 1970, the corner points mentioned in lines 1 and 2 above were in conformance with regulations and rules therefore as required in the current manual of survey instructions of the United States Department of the Interior, Bureau of Land Management or by a decree of a Court of Law and/or that the corner points mentioned in lines 3, 4 and 5 above were in conformance with the rules of the Michigan Board of Land Surveyors or by a Decree of a Court of Law; established, re-established, monumented, recovered, found as expressed below:

NOTE: Not more than 2 corners, all in the same town and range, may be recorded on this certificate.

	A	B	C	D	E	F	G	H	I	J	K	L	M
1													
2	6		5		4		3		2		1		
3													
4	7		8		9		10		11		12		
5							●						
6	18		17		16		15		14		13		
7													
8	19		20		21		22		23		24		
9													
10	30		29		28		27		26		25		
11													
12	31		32		33		34		35		36		
13													

A. Description of original monument and accessories and/or subsequent restoration:

#3 (MC-37) – 1856 – F. Coleman – GLO Resurvey
 S1°20'E Corr. between Secs. 9 & 10
 54.57 over river by offset and measurement
 on random and set meander post 8 L. S of old one.
 Bank being washed away.
 1) Sugar 6" N52°W 12 L.
 2) Sugar 6" S67°E 20 L.
 Thence South
 71.00 W. Pine 18" dia.
 80.00 Section Corner

B. Description of corner evidence found and/or method applied in restoring or re-establishing corner:

#3 (MC-37) – Meander Corner #37 per GLO plat being 54.57 Ch. South of 'G3' on line between Sections 9 and 10 and on the left bank of Muskegon River and also being deflection point in Section Line. Left (Southerly) Bank of river being eroded in this area and position for Meander Corner is now in the river. Calculated position of Meander corner by single proportion to GLO between 'G3' and recovered GLO 18" White Pine Line Tree stump to South at record GLO Geodetic bearing of North from Line Tree. Measured the following grid bearing and ground distance from "MC-37" – S0°28'02"W 1079.76' (South 1084.38' – GLO) to set 2" Alum. Cap on 5/8" x 34" rebar in centerline of 18" WPS – Line Tree; S0°28'02"W 1677.94' (South 1678.38' – GLO) to 'G5' and N0°42'35"W 3586.26' (N1°20'W 3601.62' – GLO) to 'G3'. Calculated position of Meander corner accepted as a careful and faithful reestablishment of the position of the original corner.

C. Description of monument for corner and accessories established to perpetuate locating the position of the corner:

#3 (MC-37) – Meander Corner (position in Muskegon River)
 S0°28'02"W 71.00' from #3 - Established a **Witness Corner** to #3 (MC-37) being a set 2" Aluminum Cap on 5/8" x 34" iron rebar on the section line between Sections 9 and 10 on the left bank of the Muskegon River.
Witnesses to Witness Corner
 S0°28'02" W 285.85' to S 1/16 corner common to Sec. 9 & 10 – 2" Alum. Cap on 5/8" x 34" rebar
 S0°28'02" W 1606.94' to 'G5' – DNR Monument
 S25°W 11.92' to set nail and tag in E. side of 19" Red Maple
 N77°W 55.50' to set nail and tag in S side of 15" Red Maple
 North 15' +/- to top of bank of river
 West 1' to set Blue Carsonite Post with location tag

Signed by: Craig W. McVean
 Surveyor's Michigan License No.: 39088

Date: 4/15/2009

