

LAND CORNER RECORDATION CERTIFICATE
 Filing Requirement of Act 74, Mich. PA 1970
REMONUMENTATION

For Corners In:
 Clare _____ Located In _____ Corner Code # _____
 (County)



1. Public Land Survey T 19N R 6W G4
 T _____ R _____ _____
 2. Property Controlling in Section S _____ T _____ R _____
 S _____ T _____ R _____
 3. Miscellaneous Property in Section S _____ T _____ R _____
 S _____ T _____ R _____

4. Lot No: _____ Recorded Plat: _____

5. Private Claims: _____

I, Craig W. McVean, in a field survey on Sept. 9, 2008 do hereby state that under requirements of PA 74, Michigan PA of 1970, the corner points mentioned in lines 1 and 2 above were in conformance with regulations and rules therefore as required in the current manual of survey instructions of the United States Department of the Interior, Bureau of Land Management or by a decree of a Court of Law and/or that the corner points mentioned in lines 3, 4 and 5 above were in conformance with the rules of the Michigan Board of Land Surveyors or by a Decree of a Court of Law; established, re-established, monumented, recovered, found as expressed below:

NOTE: Not more than 2 corners, all in the same town and range, may be recorded on this certificate.

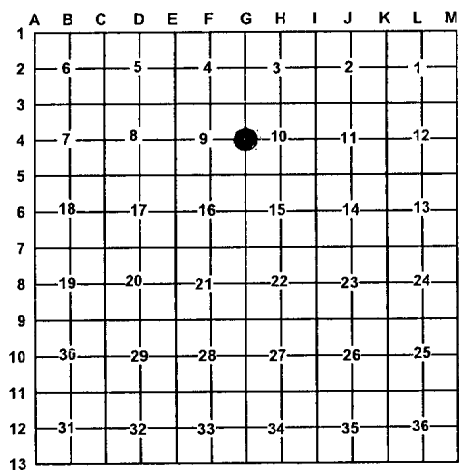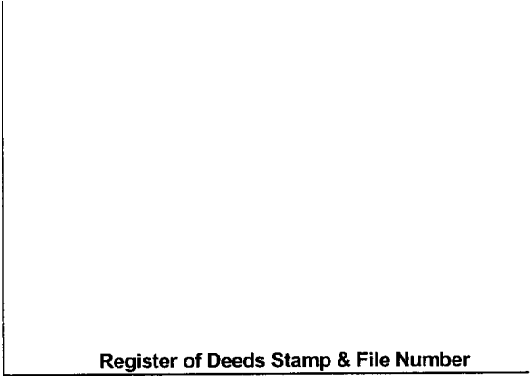

A. Description of original monument and accessories and/or subsequent restoration:

G4 – **1856** – GLO – F. Coleman, S1°20'E 40.00, set ¼ post
 1) Fir 10" N61°E 29 L
 2) W. Ash 12" S31°W 39 L
 S1°20'E 54.57 over river by offset and measurement on random and set Meander post 8 L. S. of old one. Bank being washed away.
 Thence South 71.00 W. Pine 18" dia.
 - **1914** – County Surveyor Record – L. 6, p. 227
 West 8.8. chs to river

B. Description of corner evidence found and/or method applied in restoring or re-establishing corner:

G4 – ¼ Corner common to Section 9 & 10, T19N, R6W – No evidence of GLO or County Survey position. Set 4" DNR Alum. Cap on 1" x 4' long galv. iron pipe by single proportion between 'G3' and GLO White Pine line tree stump to South (GLO – 18" W. Pine @ 71.00 CH) and online between 'G3' and calculated 'MC-37' position in river (Meander corner # 37 per GLO plat and deflection point in section line). Measured Grid Bearing and distances as follows: N0°42'35"W 2628.71' (N1°20'W 2640' – GLO) to 'G3' and S0°42'35"E 957.51' (S1°20'E 961.62' – GLO) to 'MC-37' – now in river. Measured North 435' (421.74' to Meander post – GLO) to edge of abandoned river channel and South 253' (293.7' to Meander post – GLO) to left bank of Muskegon River. DNR Monument accepted as a careful and faithful reestablishment of the position of the original corner.

C. Description of monument for corner and accessories established to perpetuate locating the position of the corner:

G4 – Stamped 4" DNR Aluminum Cap on 1" x 4' long galvanized iron pipe.
 Set Orange Carsonite Post 1' North
 S25°W 61.20' to set Nail & Tag in NW side 18" W. Oak scribed 'XBT'
 S75°W 38.67' to set Nail & Tag in S. side 8" R. Maple scribed 'XBT'
 N10°E 54.92' to set Nail & Tag in NW side 18" R. Maple scribed 'XBT'
 N54°E 18.50' to set Nail & Tag in N. side 24" R. Maple scribed 'XBT'



Signed by: Craig W. McVean
 Surveyor's Michigan License No.: 39088

Date: 10/20/2008