

LAND CORNER RECORDATION CERTIFICATE
 Filing Requirement of Act 74, Mich. PA 1970
REMONUMENTATION

For Corners In:
 Clare _____ Located In _____ Corner Code # _____
 (County)

1. Public Land Survey T 19N R 6W #1
 T _____ R _____

2. Property Controlling in Section S _____ T _____ R _____
 S _____ T _____ R _____

3. Miscellaneous Property in Section S _____ T _____ R _____
 S _____ T _____ R _____


4. Lot No: _____ Recorded Plat: _____

5. Private Claims: _____

I, Craig W. McVean, in a field survey on Feb. 28, 2008 do hereby state that under requirements of PA 74, Michigan PA of 1970, the corner points mentioned in lines 1 and 2 above were in conformance with regulations and rules therefore as required in the current manual of survey instructions of the United States Department of the Interior, Bureau of Land Management or by a decree of a Court of Law and/or that the corner points mentioned in lines 3, 4 and 5 above were in conformance with the rules of the Michigan Board of Land Surveyors or by a Decree of a Court of Law; established, re-established, monumented, recovered, found as expressed below:

NOTE: Not more than 2 corners, all in the same town and range, may be recorded on this certificate.

Register of Deeds Stamp & File Number

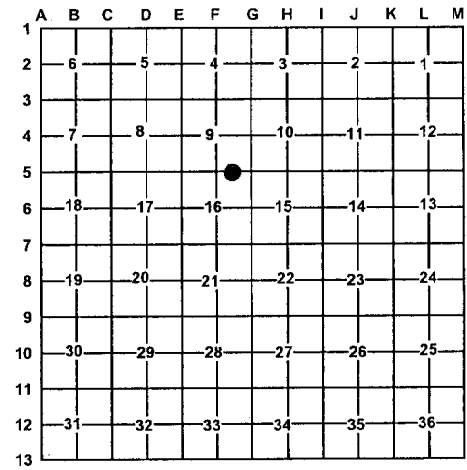

A. Description of original monument and accessories and/or subsequent restoration:

#1 (MC-19) – 1856 – GLO Resurvey – F. Coleman – West between Sec. 9 & 16 - 20.10 - Over river
 - 21.04- Old meander corner
 1) Hem. 12" (not 27) N27°W 33 L.
 2) Hem. 14" (not 20) S21°W 23 L.
 Old bearings remarked; thence S86°47'W 41.40 – Set ¼ Sec. Post

B. Description of corner evidence found and/or method applied in restoring or re-establishing corner:

#1 (MC-19) – Meander corner #19 per GLO plat on right bank of Muskegon River between Sec. 9 & 16 – No evidence of GLO post or witnesses. Set 2" Alum. Cap on 5/8" x 34" rebar by extending Section line Easterly from 'E5' through 'F5' per GLO notes to single proportion to GLO position between 'F5' and 'G5'. From 'MC-19' to 'F5' is grid bearing and distance S87°16'05"W 1345.99 (S86°47'W 1343.76' – GLO) and from 'MC-19' to 'G5' is S89°14'45"E 1390.95' (East 1388.64' – GLO). This position is on elevated bank on westerly side of the river. East 45' (62'-GLO) to edge of river – course SE. 2" Alum. Cap accepted as a careful and faithful reestablishment of the position of the original corner.

C. Description of monument for corner and accessories established to perpetuate locating the position of the corner:

#1 (MC-19) – Stamped 2" Aluminum Cap on 5/8" x 34" rebar
 Set Blue Carsonite Post with loc. Tag 1' N
 S40°E 6.45' to set nail & tag in NE side 9" Cedar scribed 'XBT'
 N9°E 21.22' to set nail & tag in W. side 7" Oak scribed 'XBT'
 N38°W 44.66' to set nail & tag in W. side 11" R. Maple scribed 'XBT'
 N89°W 14.28' to set nail & tag in S. side 13" Basswood scribed 'XBT'
 S89°14'45"E 294.19' (293.7' – GLO) to 'MC-36' (2" Aluminum Cap on Left Bank of River)



Signed by: Craig W. McVean
 Surveyor's Michigan License No.: 39088

Date: 10/20/2008