

SURVEY & REMONUMENTATION COMMISSION
 APR 06 1995
 For corners in


LAND CORNER RECORDATION CERTIFICATE
 Filing Requirement of Act 74, Mich. P.A. 1970

RECEIVED
 E 10 A.D.
 #72-94
 94 DEC 29 AM 8:47
 REGISTER OF DEEDS
 CLARE COUNTY
 DONNA M. CARR

	Located In:	Corner Code -#
1. Public Land Survey	T <u>19N</u> R <u>3W</u>	<u>G-7</u>
	T _____ R _____	_____
	T _____ R _____	_____
	T _____ R _____	_____
2. Property Controlling in Section	S _____ T _____ R _____	_____
	S _____ T _____ R _____	_____
3. Miscellaneous Property in Sec.	S _____ T _____ R _____	_____
	S _____ T _____ R _____	_____
4. Lot No. _____, Recorded Plat _____		
5. Private Claims _____		

Register of Deeds Stamp & File Number

I, MARK R. ROBISON, in a field survey on DECEMBER, 19 94, do hereby certify that under requirements of P.A. 74, Michigan P.A. of 1970, the corner points mentioned in lines 1 and 2 above were in conformance with regulations and rules therefore as required in the current manual of survey instructions of the United States Department of the Interior, Bureau of Land Management or by a decree of a Court of Law and/or that the corner points mentioned in lines 3, 4 and 5 above were in conformance with the rules of the Michigan Board of Land Surveyors or by a Decree of a Court of Law; established, re-established, monumented, re-monumented, recovered, found as expressed below:

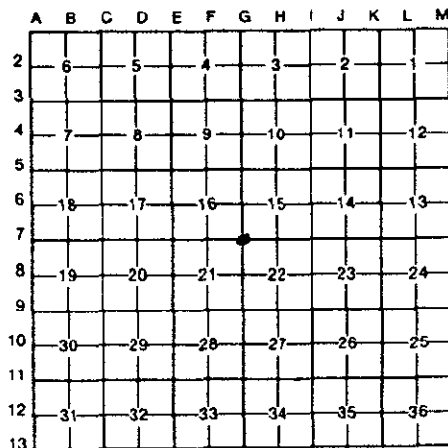

NOTE: Not more than 4 corners, all in the same town and range, may be recorded on this certificate.

- A. Description of original monument and accessories and/or subsequent restoration:
- 1856 CANNON, G.L.O. P.411 POST WIT.-(1)BEECH 8" S03°E 29 LKS. (2)W. PINE 18" N40°W 39 LKS.
 - 4-6-10 A. JOHNSON, C.S.R. L.2, PG.1, L.5 PG.5 WIT.-(2) & (3)ABOVE
 - 5-19-1889 C.S.R. L.5, PG.94 WIT.-(2)ABOVE (3)PINE 20" N25°E 90 LKS.
 - 4-20-07 A. JOHNSON, C.S.R. L.4, PG.99, L.4, PG.120 WIT.-(2) & (3) ABOVE (4)TOWN HALL S26°W 114 LKS.
 - 11-15-62 LAPHAM, UNRECORDED SURVEY G-7 TO G-8 = 2625.9 FEB. 1962 LAPHAM, UNRECORDED SURVEY G-7 TO H-7 = 2636 NOTES STATE AXE BLADE, POST, GLASS & TILE FOUND AT CORNER & 2 C.S.R. WITNESSES.
 - 6-7-72 LAPHAM, BENTLY SUBD. PLAT, L.13, PG.24 L.13, PG.24

- 10-18-71 LAPHAM, L.C.R.C. #21 WIT.-(3)ABOVE & (4)S45°W 79.0' N.E. COR. TWF (5)S45°E 64.0' POWER POLE HALL
- 12-18-72 LAPHAM, (132) L.1, PG.397 WIT.-(4) & (5)ABOVE
- 1-10-77 SEDGMAN, (132) L.2, PG. 254 FOUND 1/2" PIPE WIT.-(5)ABOVE (6)N45°E 70.51' POWER POLE (7)S40°W 62.22' N.E. COR. BLDG.
- 9-25-91 LAPHAM, (132) L.3, PG.301 FOUND CAPPED IRON IN MON. BOX WIT.-(3) (4) & (5)ABOVE

B. Description of corner evidence found and/or method applied in restoring or reestablishing corner:

FOUND CAPPED IRON IN MON. BOX IN ASPHALT AT INTERSECTION OF CENTER-LINES. EXCAVATED TO 2 1/2 FEET IN SAND & FOUND STONE TOO LARGE TO BE REMOVED THROUGH MON. BOX. WITNESSES #4, 5, 6 & 7 APPROXIMATELY FIT THE IRON IN THE MON. BOX, MEAS. EAST 2636.28' TO H-7 (PREVIOUS SURVEY 2636 & 2635.25). MEAS. NORTH 2624.98' TO G-6 (PREVIOUS SURVEY 2623.49 & 2625.9). DESPITE MINOR INCONSISTANCIES BETWEEN MEASURED DISTANCES, I ACCEPTED THE LONG STANDING IRON IN THE MON. BOX AS THE LOCATION OF THE SECTION CORNER.


APPROVED LAND CORNER
 P.A. 345 of 1990
 Clare County
 Chairman Paul B. Popko
 Date 12-19-94

This Corner established in Clare County Remonumentation Program.

See dossier for detailed report.

C. Description of monument for corner and accessories established to perpetuate locating the position of the corner:

SET 5/8" X 18" RE-ROD WITH 3" CLARE COUNTY MONUMENT CAP IN MONUMENT BOX.
 WITNESS:
 N50°E 70.60' - NAIL & TAG IN POWER POLE (6)
 S50°E 64.23' - NAIL & TAG IN POWER POLE (5)
 S40°W 62.45' - N.E. CORNER CONCRETE BLOCK BLDG. (7)
 S75°W 110.85' - N.W CORNER CONCRETE BLOCK BLDG.

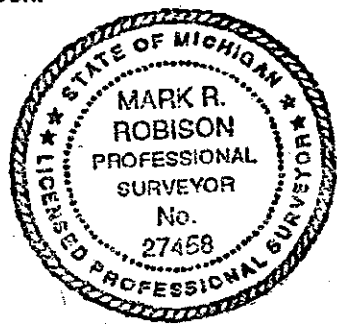

Signed by Mark R. Robison
 Surveyor's Michigan License No. 27458

Date 12-19-94