

SURVEY & REMONUMENTATION COMMISSION
APR 06 1995
 CLARE (County)

LAND CORNER RECORDATION CERTIFICATE
 Filing Requirement of Act 74, Mich. P.A. 1970

RECEIVED
 E 10 AD
 IF 82-94
 94 DEC 29 AM 8:48

REGISTER OF DEEDS
 CLARE COUNTY
 DONNA M. CARR

For corners in _____ Located In: _____ Corner Code # _____

1. Public Land Survey	T 19N R 3W	H-7
	T _____ R _____	_____
	T _____ R _____	_____
	T _____ R _____	_____
2. Property Controlling in Section	S _____ T _____ R _____	_____
	S _____ T _____ R _____	_____
3. Miscellaneous Property in Sec.	S _____ T _____ R _____	_____
	S _____ T _____ R _____	_____

4. Lot No. _____, Recorded Plat _____

5. Private Claims _____

Register of Deeds Stamp & File Number

	A	B	C	D	E	F	G	H	I	J	K	L	M
2	6	5	4	3	2	1							
3													
4	7	8	9	10	11	12							
5													
6	18	17	16	15	14	13							
7													
8	19	20	21	22	23	24							
9													
10	30	29	28	27	26	25							
11													
12	31	32	33	34	35	36							
13													

I, MARK R. ROBISON, in a field survey on NOVEMBER, 19 94, do hereby certify that under requirements of P.A. 74, Michigan P.A. of 1970, the corner points mentioned in lines 1 and 2 above were in conformance with regulations and rules theretore as required in the current manual of survey instructions of the United States Department of the Interior, Bureau of Land Management or by a decree of a Court of Law and/or that the corner points mentioned in lines 3, 4 and 5 above were in conformance with the rules of the Michigan Board of Land Surveyors or by a Decree of a Court of Law; established, re-established, monumented, re-monumented, recovered, found as expressed below:

NOTE: Not more than 4 corners, all in the same town and range, may be recorded on this certificate.

A. Description of original monument and accessories and/or subsequent restoration:

- | | |
|---|--|
| 1856 CANNON, G.L.O. PG.411
POST
WIT.-(1)CEDAR 13" N75°W 19 LKS
(2)CEDAR 14" S31°E 22LKS | 2-64 LAPHAM, UNRECORDED SURVEY
NO WITNESSES. |
| 5-19-1889 C.S.R. L.5, PG.94
WIT.-(3)PINE 30" N38 1/2°W 74 LKS.
(4)PINE 30" S65°E 92 LKS. | 10-18-71 LAPHAM, L.C.R.C. #21
1" PINCH IRON
WIT.-(3)N38 1/2°W 48.84' (O.B.T.)
(5)N61°E 51.3' POWER POLE
(6)S66°E 101' 4" BIRCH |
| 7-19-07 A JOHNSON, C.S.R. L.4-PG.120
WIT.-(3)PINE 30" N38 1/2°W 74 LKS.
(4)PINE 30" S65°E 92 LKS. | 1-10-77 SEDGMAN, (132) L.2-PG.254
FOUND 1/2" BAR
WIT.-(5)N60°E 51.91' POWER POLE
(7)N25°W 49.93' 4" BIRCH
(8)S60°E 88.81' 8" HEMLOCK |

B. Description of corner evidence found and/or method applied in restoring or reestablishing corner:

FOUND 1/2"x18" RE-ROD IN MON. BOX IN CENTER OF WEST-BOUND LANE. EXCAVATED TO 3' DEEP.
 FOUND NO OTHER EVIDENCE. MEAS. 2635.68' TO G-7 (2636 PER UNRECORDED LAPHAM SURVEY)
 FOUND WITNESSES NOS. (3), (5), (6), (7) & (8).

APPROVED LAND CORNER
 P.A. 345 of 1990
 Clare County
 Chairman Paul D. Lapham
 Date 11-22-94


This Corner established in Clare County Remonumentation Program.

See dossier for detailed report.

C. Description of monument for corner and accessories established to perpetuate locating the position of the corner:

SET 5/8" X 36" RE-ROD WITH 3" CLARE COUNTY MONUMENT CAP IN MONUMENT BOX.

- WITNESSES:
 N60°E 51.91' - NAIL & TAG IN POWER POLE (5)
 S15°E 88.18' - NAIL & TAG IN 10" HEMLOCK
 NORTH 32.77' CONCRETE MONUMENT IN SWAMP
 S66°E 101.00' - NAIL & TAG IN 8" BIRCH (6)

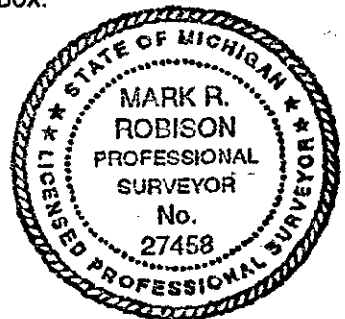

Signed by Mark R. Robison Date 11-22-94
 Surveyor's Michigan License No. 27458