

CONVEY &
REMONUMENTATION

APR 06 1995

LAND CORNER RECORDATION CERTIFICATE
Filing Requirement of Act 74, Mich. P.A. 1970

RECEIVED
E 10 A 0
#80-94
94 DEC 29 AM 8:48

For corners in

CLARE
(County)

Located In:

Corner Code #

REGISTER OF DEEDS
CLARE COUNTY
DONNA M. CARR

- | | | |
|---------------------------------------|--------------------------|------------|
| 1. Public Land Survey | T <u>19N</u> R <u>3W</u> | <u>J-7</u> |
| | T _____ R _____ | _____ |
| | T _____ R _____ | _____ |
| | T _____ R _____ | _____ |
| 2. Property Controlling in Section | S _____ T _____ R _____ | _____ |
| | S _____ T _____ R _____ | _____ |
| 3. Miscellaneous Property in Sec. | S _____ T _____ R _____ | _____ |
| | S _____ T _____ R _____ | _____ |
| 4. Lot No. _____, Recorded Plat _____ | | |
| 5. Private Claims _____ | | |

Register of Deeds Stamp & File Number

I, MARK R. ROBISON, in a field survey on OCTOBER, 19 94, do hereby certify that under requirements of P.A. 74, Michigan P.A. of 1970, the corner points mentioned in lines 1 and 2 above were in conformance with regulations and rules therefore as required in the current manual of survey instructions of the United States Department of the Interior, Bureau of Land Management or by a decree of a Court of Law and/or that the corner points mentioned in lines 3, 4 and 5 above were in conformance with the rules of the Michigan Board of Land Surveyors or by a Decree of a Court of Law; established, re-established, monumented, re-monumented, recovered, found as expressed below:

| | A | B | C | D | E | F | G | H | I | J | K | L | M |
|----|----|----|----|----|----|----|---|---|---|---|---|---|---|
| 2 | 6 | 5 | 4 | 3 | 2 | 1 | | | | | | | |
| 3 | | | | | | | | | | | | | |
| 4 | 7 | 8 | 9 | 10 | 11 | 12 | | | | | | | |
| 5 | | | | | | | | | | | | | |
| 6 | 18 | 17 | 16 | 15 | 14 | 13 | | | | | | | |
| 7 | | | | | | | | | | | | | |
| 8 | 19 | 20 | 21 | 22 | 23 | 24 | | | | | | | |
| 9 | | | | | | | | | | | | | |
| 10 | 30 | 29 | 28 | 27 | 26 | 25 | | | | | | | |
| 11 | | | | | | | | | | | | | |
| 12 | 31 | 32 | 33 | 34 | 35 | 36 | | | | | | | |
| 13 | | | | | | | | | | | | | |

NOTE: Not more than 4 corners, all in the same town and range, may be recorded on this certificate.

- A. Description of original monument and accessories and/or subsequent restoration:
- 1856, CANNON, POST (1) HEMLOCK 8" N08°E 10 1/2 LKS (2)HEMLOCK 6" S61°E 20 LKS G.L.O.
 - 5-19-1889 (3)W. PINE 30" S46°W 75 LKS (4)W. PINE 24" S41°E 78 LKS (5) PINE STUMP EAST 41 LKS (6)PINE 24" S72°W 76 1/2 LKS (7)PINE 24" N46°W 54 LKS C.S.R. 95-5
 - 7-19-07 A.JOHNSON, (5)PINE STUMP EAST 41 LKS C.S.R. 112-4
 - 10-4-74 LAPHAM, FOUND IRON (8)N60°W 57.5' 6" THORN APPLE (9)NORTH 31.2' CORNER FENCE POST (132) 1-783
 - 10-8-74 LAPHAM, IRON (8)N60°W 57.5' 6" THORN APPLE (9)NORTH 31.2' CORNER POST L.C.R.C. #171

- B. Description of corner evidence found and/or method applied in restoring or reestablishing corner:
- FOUND MON. BOX IN @ NEW ASPHALT PVM'T. EXCAVATED & FOUND 1/2"x10" IRON 2 FEET DEEP IN OLD ROAD BED. REMOVED & FOUND 3/4" PIPE UNDER IRON. COULD NOT REMOVE. SET MONUMENT OVER PIPE. FOUND WITNESS #9, 31.9 FEET NORTH (R. 31.2)


APPROVED LAND CORNER
P.A. 345 of 1990
Clare County
Chairman Paul D. Lapham
Date 11-22-94

This Corner established in Clare County Remonumentation Program.

See dossier for detailed report.

- C. Description of monument for corner and accessories established to perpetuate locating the position of the corner:

SET 5/8" X 36" RE-ROD WITH 3" CLARE COUNTY MONUMENT CAP IN MONUMENT BOX.
NEW WITNESSES:
NORTH 32.38' CAPPED IRON #18664
N50°E 46.22' 6" W. PINE
S65°E 75.32' 8" W. PINE
S10°E 98.03' POWER POLE

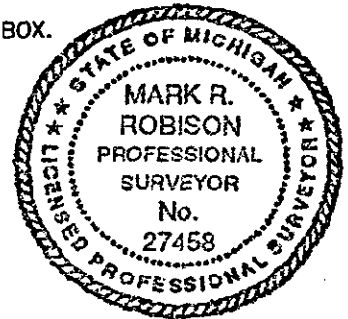

Signed by Mark R. Robison Date 11-22-94
Surveyor's Michigan License No. 27458