

SURVEY & REMONUMENTATION COMMISSION

APR 06 1995

LAND CORNER RECORDATION CERTIFICATE
Filing Requirement of Act 74, Mich. P.A. 1970

RECEIVED
E 10 A D
#79-94
94 DEC 29 AM 8:48

REGISTER OF DEEDS
CLARE COUNTY
DONNA M. CARR

For corners in CLARE (County) Located In: _____ Corner Code # _____

1. Public Land Survey T 19N R 3W _____ K-7
T _____ R _____
T _____ R _____
T _____ R _____

2. Property Controlling S _____ T _____ R _____
in Section S _____ T _____ R _____

3. Miscellaneous S _____ T _____ R _____
Property in Sec. S _____ T _____ R _____

4. Lot No. _____, Recorded Plat _____

5. Private Claims _____

Register of Deeds Stamp & File Number

A	B	C	D	E	F	G	H	I	J	K	L	M
2	6	5	4	3	2							
3												
4	7	8	9	10	11	12						
5												
6	18	17	16	15	14	13						
7												
8	19	20	21	22	23	24						
9												
10	30	29	28	27	26	25						
11												
12	31	32	33	34	35	36						
13												

I, MARK R. ROBISON, in a field survey on OCTOBER, 19 94, do hereby certify that under requirements of P.A. 74, Michigan P.A. of 1970, the corner points mentioned in lines 1 and 2 above were in conformance with regulations and rules therefore as required in the current manual of survey instructions of the United States Department of the Interior, Bureau of Land Management or by a decree of a Court of Law and/or that the corner points mentioned in lines 3, 4 and 5 above were in conformance with the rules of the Michigan Board of Land Surveyors or by a Decree of a Court of Law, established, re-established, monumented, re-monumented, recovered, found as expressed below:

NOTE: Not more than 4 corners, all in the same town and range, may be recorded on this certificate.

A. Description of original monument and accessories and/or subsequent restoration:

- 1856 CANNON, POST, (1) CEDAR 7" S53°E 15 LKS (2) HEMLOCK 18" N45°W 32 LKS, G.L.O. 5-19-1889 (3) HEMLOCK 10" S35°W 41 LKS (4) ELM 12" S32°W 66 LKS (5) S.W. CORNER SCHOOL WALL N28 1/2°E 180 LKS (6) BEACH 12" N78°E 44 LKS, C.S.R. 5-95
- 5-6-07 A. JOHNSON, (4) - ABOVE (7) BEECH 11" N37°E 26 LKS, CSR 4-102
- 6-3-07 A. JOHNSON, (4 & 5) - ABOVE, CSR 5-86 (4 & 7) - ABOVE, CSR 5-85
- 7-19-07 A. JOHNSON, (3 & 6) - ABOVE, CSR 4-112
- 10-18-10 (4 & 5) - ABOVE, CSR 3-2
- 10-2-72 LAPHAM, (8) N45°W 47.52' POWER POLE (9) S40°W 46.66' POWER POLE (10) S80°E 70.88' BOX ELDER, L.C.R.C. #61
- 10-4-74 LAPHAM, REFER TO L.C.R.C. #61 (132) 1-783
- 10-29-82 PORTER, NO WITNESSES, (132) 2-743

B. Description of corner evidence found and/or method applied in restoring or reestablishing corner:

SURVEYED LOCATION OF SECTION CORNER FROM SURVEY L.1 P.783. MEASURED S00°30'30"W, 2608.70' FROM 13-14 1/4 CORNER ACROSS N.E. CORNER PARCEL J TO SEC. CORNER, MEAS. NORTH FROM SEC. CORNER, 532.25' TO N.E. CORNER. PARCEL J. MEAS. WEST 2631.65 FEET TO S 1/4 CORNER SEC. 14. MEAS. WEST 658.01' TO S.W. CORNER OF PARCEL L. FOUND 1"x15" PIPE IN ASPHALT 0.9' SOUTH OF SECTION CORNER. FOUND WITNESS NO. 5. ALL OTHER WITNESSES GONE. EXCAVATED AND FOUND 3/4"x15" PIPE BENT APPROXIMATELY 0.5' SOUTH OF CORNER. FOUND NO OTHER EVIDENCE;

APPROVED LAND CORNER
P.A. 345 of 1990
Clare County


Chairman Paul S. Lapham
Date 11-22-94

This Corner established in Clare County Remonumentation Program.

See dossier for detailed report.

C. Description of monument for corner and accessories established to perpetuate locating the position of the corner:

- SET 5/8" X 36" RE-ROD WITH 3" CLARE COUNTY MONUMENT CAP IN MONUMENT BOX.
- S30°E 141.05' - NAIL & TAG - POWER POLE
- N29 1/2 ° E 114.80' S.W. CORN. STONE BLDG. (5)
- N20°W 167.24' - NAIL & TAG IN POWER POLE GUY POST
- N45°W 56.93' - NAIL & TAG IN TELE. STUD POLE

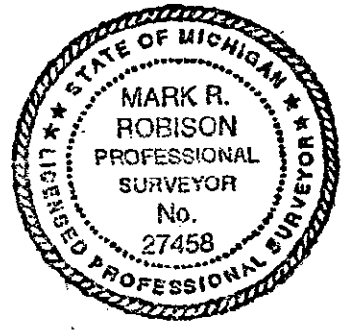

Signed by Mark R. Robison

Date 11-22-94

Surveyor's Michigan License No. 27458