REMONUMENTATION
APR 06 1995
COMMISSION

RECEIVED
E ☑ I ☐ A ☐
# 77-94
94 DEC 29 AM 8:48

REGISTER OF DEEDS
CLARE COUNTY
DONNA M CARR

# LAND CORNER RECORDATION CERTIFICATE

**Filing Requirement of Act 74, Mich. P.A. 1970**

For corners in CLARE (County)

| | Located In: | Corner Code # |
|---|---|---|
| 1. Public Land Survey | T 19N R 3W | M-7 |
| | T ___ R ___ | |
| | T ___ R ___ | |
| | T ___ R ___ | |
| 2. Property Controlling | S ___ T ___ R ___ | |
| in Section | S ___ T ___ R ___ | |
| 3. Miscellaneous | S ___ T ___ R ___ | |
| Property in Sec. | S ___ T ___ R ___ | |

**Register of Deeds Stamp & File Number**

4. Lot No. _____ , Recorded Plat _____
5. Private Claims _____

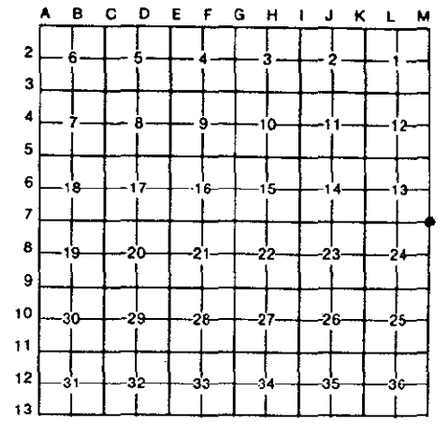


I, MARK R. ROBISON, in a field survey on NOVEMBER, 19 94, do hereby certify that under requirements of P.A. 74, Michigan P.A. of 1970, the corner points mentioned in lines 1 and 2 above were in conformance with regulations and rules therefore as required in the current manual of survey instructions of the United States Department of the Interior, Bureau of Land Management or by a decree of a Court of Law and/or that the corner points mentioned in lines 3, 4 and 5 above were in conformance with the rules of the Michigan Board of Land Surveyors or by a Decree of a Court of Law; established, re-established, monumented, re-monumented, recovered, found as expressed below:

**NOTE: Not more than 4 corners, all in the same town and range, may be recorded on this certificate.**

A. Description of original monument and accessories and/or subsequent restoration:

1838 NICHOLSON, G.L.O. PG.401
WIT.-(1)BEECH 7" S18°W 09 LKS.
(2)BEECH 11" N07°W 18 LKS.

C.S.R. L.5, PG.85
WIT.-(2)BEECH 14" N07°W 18 LKS.
(3)HEMLOCK 8" S67°W 69 LKS.
(4)HEMLOCK 10" S35°W 41 LKS.

5-6-07 A. JOHNSON, C.S.R. L.4, PG. 102
WIT.-(2)BEECH 14" N07°W 18 LKS.
(3)HEMLOCK 8" S67°W 69 LKS.

6-3-07 A. JOHNSON, C.S.R. L.4, PG. 106
WIT.-(4)HEMLOCK 10" S35°W 41 LKS.
(5)BEECH 12" N78 1/2°E 44 LKS.

1-3-1992 J. MEYERS, (132) L.3, PG.332
FOUND 1/2" PIPE
WIT.-(6)S60°E 30.8' 30" OAK
(7)N50°W 51.20' 24" MAPLE
(8)S55°W 29.60' 4" MAPLE

DRAWING OF SURVEY OF SEC.'S 18 & 19
T19N, R2W FROM PAUL B. LAPHAM & ASSOC. FILES

B. Description of corner evidence found and/or method applied in restoring or reestablishing corner:

MEASURED EAST 2604.11' FROM L-7 PER MEYERS SURVEY.
FOUND 1/2"x18" IRON. EXCAVATED TO 2', FOUND 1/2"x30" PIPE. EXCAVATED TO 3', FOUND NO OTHER EVIDENCE.
FOUND WITNESSES #6 & 7. GRAVEL SURFACE

APPROVED LAND CORNER
P.A. 345 of 1990
Clare County
Chairman Paul B. Lapham
Date 11-22-94

This Corner established in Clare County Remonumentation Program.

See dossier for detailed report.

C. Description of monument for corner and accessories established to perpetuate locating the position of the corner:

SET 5/8" X 36" RE-ROD WITH 3" CLARE COUNTY MONUMENT CAP IN MONUMENT BOX.
WITNESSES:
S65°E 30.08' 30" OAK STUMP - NAIL & TAG (6)
N47°W 51.20' 20" MAPLE - NAIL & TAG (7)
N70°W 75.80' 28" R. OAK - NAIL & TAG
N45°E 75.91' 26" TWIN ASH - NAIL & TAG

STATE OF MICHIGAN
MARK R. ROBISON
PROFESSIONAL SURVEYOR
No. 27458
LICENSED PROFESSIONAL SURVEYOR

Signed by Mark R. Robison Date 11-22-94

Surveyor's Michigan License No. 27458

FORM APPROVED BY MICHIGAN STATE BOARD OF LAND SURVEYORS, JAN. 28, 1971
REVISED MAY 14, 1975
REVISED JAN., 1983