

SURVEY & REMONUMENTATION

FEB 18 1994

CLARE COUNTY REMONUMENTATION PROGRAM

COMMISSION

LAND CORNER RECORDATION CERTIFICATE  
Filing Requirement of Act 74, Mich. P.A. 1970

RECEIVED  
1993 DEC 20 PM 1:48

REGISTER OF DEEDS  
CLARE COUNTY  
DONNA M. CARR

For corners in

CLARE  
(County)

Located In:

Corner Code #

- |                                    |   |     |   |    |     |
|------------------------------------|---|-----|---|----|-----|
| 1. Public Land Survey              | T | 19N | R | 4W | C-7 |
|                                    | T |     | R |    |     |
|                                    | T |     | R |    |     |
|                                    | T |     | R |    |     |
| 2. Property Controlling in Section | S |     | T | R  |     |
|                                    | S |     | T | R  |     |
| 3. Miscellaneous Property in Sec.  | S |     | T | R  |     |
|                                    | S |     | T | R  |     |
4. Lot No. \_\_\_\_\_, Recorded Plat \_\_\_\_\_
5. Private Claims \_\_\_\_\_

Register of Deeds Stamp & File Number

I, MARK R. ROBISON, in a field survey on NOVEMBER, 1993, do hereby certify that under requirements of P.A. 74, Michigan P.A. of 1970, the corner points mentioned in lines 1 and 2 above were in conformance with regulations and rules therefore as required in the current manual of survey instructions of the United States Department of the Interior, Bureau of Land Management or by a decree of a Court of Law and/or that the corner points mentioned in lines 3, 4 and 5 above were in conformance with the rules of the Michigan Board of Land Surveyors or by a Decree of a Court of Law: established, re-established, monumented, re-monumented, recovered, found as expressed below:

	A	B	C	D	E	F	G	H	I	J	K	L	M
2	6		5		4		3		2		1		
3													
4	7		8		9		10		11		12		
5													
6	18		17		16		15		14		13		
7													
8	19		20		21		22		23		24		
9													
10	30		29		28		27		26		25		
11													
12	31		32		33		34		35		36		
13													


NOTE: Not more than 4 corners, all in the same town and range, may be recorded on this certificate.

A. Description of original monument and accessories and/or subsequent restoration:  
1856 G.E. ADAIR, W. PINE 26" N 63°E, 74 LKS P. 375  
W. PINE 28" S 72-1/2°W, 24 LKS  
7-19-76 SEDGMAN, FOUND 1/2" BAR LCRC 247-76  
5-15-77 LAPHAM, (132) 2-222

B. Description of corner evidence found and/or method applied in restoring or reestablishing corner:  
FOUND 1/2" x 18" RE-BAR (POINTED) OVER 1/2" x 24" BAR. EXCAVATED TO 4', FOUND LARGE STONES AND BROKEN CROCKERY AROUND BOTH 18" AND 24" BARS. LEFT STONES IN PLACE, PUT CROCKERY BACK IN HOLE.  
FOUND RECORDED WITNESSES:  
N 70°W, 51.92' - 12" TWIN OAK  
N 50°E, 64.97' - 12" OAK  
S 40°E, 41.35' - POWER POLE  
N 45°E, 36.82' - ROAD SIGN

This Corner established in Clare County Remonumentation Program.  
See dossier for detailed report.

C. Description of monument for corner and accessories established to perpetuate locating the position of the corner:  
SET 5/8" X 36" RE-ROD WITH 3" CLARE COUNTY MONUMENT CAP.  
N 55°W, 51.94' - 18" TWIN OAK  
N 45°E, 65.00' - 24" OAK  
S 40°E, 41.34' - POWER POLE  
S 35°W, 99.05' - 22" TWIN OAK

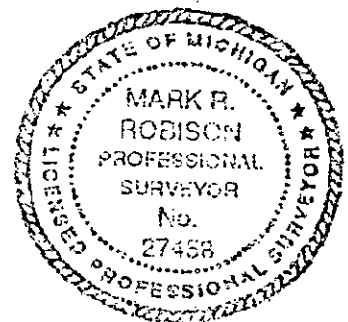

Signed by Mark R. Robison  
Surveyor's Michigan License No. 27458

Date 11/24/93