

FEB 18 1994

COMMISSION

CLARE COUNTY REMONUMENTATION PROGRAM

LAND CORNER RECORDATION CERTIFICATE
Filing Requirement of Act 74, Mich. P.A. 1970

RECEIVED
FEB 18 1994

1993 DEC 20 PM 1:48

REGISTER OF DEEDS
CLARE COUNTY
DONNA M. CARR

For corners in

CLARE
(County)

Located In:

Corner-Code #

- 1. Public Land Survey T 19N R 4W C-8
- T _____ R _____
- T _____ R _____
- T _____ R _____
- 2. Property Controlling S _____ T _____ R _____
- in Section S _____ T _____ R _____
- 3. Miscellaneous S _____ T _____ R _____
- Property in Sec. S _____ T _____ R _____

Register of Deeds Stamp & File Number

- 4. Lot No. _____, Recorded Plat _____
- 5. Private Claims _____

	A	B	C	D	E	F	G	H	I	J	K	L	M
2	6	5	4	3	2	1							
3													
4	7	8	9	10	11	12							
5													
6	18	17	16	15	14	13							
7													
8	19	20	21	22	23	24							
9													
10	30	29	28	27	26	25							
11													
12	31	32	33	34	35	36							
13													

I, MARK R. ROBISON in a field survey on NOVEMBER, 19 93, do hereby certify that under requirements of P.A. 74, Michigan P.A. of 1970, the corner points mentioned in lines 1 and 2 above were in conformance with regulations and rules therefore as required in the current manual of survey instructions of the United States Department of the Interior, Bureau of Land Management or by a decree of a Court of Law and/or that the corner points mentioned in lines 3, 4 and 5 above were in conformance with the rules of the Michigan Board of Land Surveyors or by a Decree of a Court of Law; established, re-established, monumented, re-monumented, recovered, found as expressed below:


NOTE: Not more than 4 corners, all in the same town and range, may be recorded on this certificate.

A. Description of original monument and accessories and/or subsequent restoration:
 1856 G.E. ADAIR, P.388 W.PINE 13, N16E 551ks, W.PINE 13, S44 1/2 W, 14 1/2 k.s.
 10-2-72 LAPHAM, FOUND 3/4" PIPE, LCRC 62-72
 7-19-76 SEDGMAN, LCRC 247-76

B. Description of corner evidence found and/or method applied in restoring or reestablishing corner:
 FOUND 3/4" x 36" PIPE BADLY RUSTED. ALSO FOUND 1" x 8" PIPE, BADLY RUSTED, ALONG SIDE & RUSTED TOGETHER. EXCAVATED TO 42", FOUND NO OTHER EVIDENCE.
 FOUND RECORDED WITNESSES:
 N 50°E, 51.19' - 27" OAK
 S 57°W, 67.72' - 11" OAK
 N 55°W, 27.66' - 15" MAPLE
 S 85°W, 28.32' - POWER POLE
 N 35°E, 54.33' - 14" OAK

This Corner established in Clare County Remonumentation Program. See dossier for detailed report.

C. Description of monument for corner and accessories established to perpetuate locating the position of the corner:
 SET 5/8" X 36" RE-ROD WITH 3" CLARE COUNTY MONUMENT CAP.
 N 35°E, 51.44' - 36" OAK
 N 60°W, 27.70' - 30" MAPLE
 S 57°W, 67.78' - 16" OAK
 S 85°W, 28.32' - POWER POLE

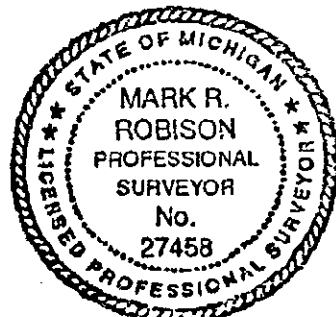

Signed by Mark R. Robison
 Surveyor's Michigan License No. 27458

Date 11/24/93