

CLARE County Remonumentation
LAND CORNER RECORDATION CERTIFICATE
 Filing Requirement of Act 74, Mich. P.A. 1970

RECORDED
 # 265-98
 98 NOV 18 AM 9:54
 REGISTER OF DEEDS
 CLARE COUNTY
 CAROL A. MAULAY

For corners in

CLARE Located in: Corner Code #
 (County)

1. Public Land Survey	T20N R04W	D-13
	T19NR04W	D-1
	T ___ R ___	_____
	T ___ R ___	_____
2. Property Controlling in Section	S ___ T ___ R ___	_____
	S ___ T ___ R ___	_____
3. Miscellaneous Property in Sec.	S ___ T ___ R ___	_____
	S ___ T ___ R ___	_____

Register of Deeds Stamp & File Number

4. Lot No. _____, Recorded Plat _____
 5. Private Claims _____

I, Mark R Robison, in a field survey on June 2, 1998, do hereby state that under requirements of P.A. 74, Michigan P.A. of 1970, the corner points mention in lines 1 and 2 above were in conformance with regulations and rules therefore as required in the current manual of survey instructions of the United States Department of the Interior, Bureau of Land Management or by a decree of a Court of Law and/or that the corner points mentioned in lines 3, 4 and 5 above were in conformance with the rules of the Michigan Board of Land Surveyors or by a Decree of a Court of Law; established, re-established, monumented, recovered, found as expressed below:

	A	B	C	D	E	F	G	H	I	J	K	L
1												
2	6		5		4		3		2			
3												
4	7		8		9		10		11			
5												
6	18		17		16		15		14			
7												
8	19		20		21		22		23			
9												
10	30		29		28		27		26			
11												
12	31		32		33		34		35			
13												

NOTE: Not more than 2 corners, all in the same town and range, may be recorded on this certificate

This is a single corner common to T20N, R04W
 D-13 and T19N, R04W D-1

A. Description of original monument and accessories and/or subsequent restoration:

D-13: 1838 Nicholson GLO
 Set 1/4 Sec Post
 Wit-Y. Pine 8 S88 1/2E 62
 Y. Pine 10 S77 1/2E 56

9-20-78 Lapham LCRC#322
 Set 1/2" C.I. in Found Mon Box
 Wit-same as (132) 2-317

11-08-46 F.McClung 2-46
 Plat of Airport Forest Subd. No. 2

1-14-80 Lapham
 References corner in unrecorded survey

11-29-77 Lapham (132) 2-317
 Set Capped Rerod in Found Monument
 Wit-N55E 11.38 12" Oak
 East 24.43 12" Oak
 S30E 36.02 16" Oak
 S45W 12.40 12" Oak

SURVEY & REMONUMENTATION

NOV 25 1998

SECTION

B. Description of corner evidence found and/or method applied in restoring or reestablishing corner:


D-13: Corner has been removed but three 1977 witnesses were still there. Reset corner from data on unrecorded survey of 1980. Re-established corner fit 1977 witness trees. Measured West 2650.37 to Section Corner. Measured East 2646.41 to Section corner.

See dossier for detailed report.

C. Description of monument for corner and accessories established to perpetuate locating the position of the corner:

D-13: Set 5/8" x 36" rerod with Clare Co. Remon. Cap marked P.S.#27458. Accepted as best available evidence of the accepted position of the corner.

Witnesses:
 S10W 35.00', nail & tag, 22" R. Oak
 N55E 11.38', nail & tag, 17" R. Oak (OBT)
 East 24.43', nail & tag, 16" R. Oak (OBT)
 S45W 12.40', nail & tag, 16" R. Oak (OBT)

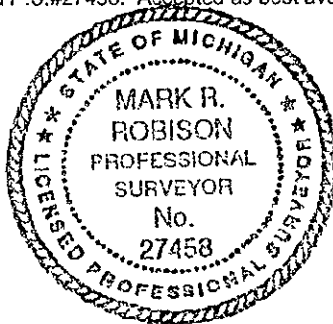

APPROVED LAND CORNER
 P.A. 345 of 1990
 Clare County

Chairman Paul A. Lapham
 Date 9-22-98

Signed by Mark R. Robison
 Surveyor's Michigan License No. 27458

Date 11-16-98