

## FEB 1 8 1994

## RECEIVED CLARE COUNTY REMONUMENTATION PROGRAM | | | A |

## COMMISSION

For corners in

Property in Sec.

## LAND CORNER RECORDATION CERTIFICATE

1993 DEC 20 PM 1: 48

Filing Requirement of Act 74, Mich. P.A. 1970

	CLARE		Located In:			Corner Code ##			
	(County)		Located III.		·				
1.	Public Land Survey		T R	4W		E-7			
	·		. TR.		-				
		•	T R			<u></u>	·		
	<b>,</b> .		T R						
2.	Property Controlling	S	T R						
	in Section	s	T R						
2	Miccollangous	•	т р						

REGISTER OF DEEDS CLARE COUNTY DONNA M. CARR

Register of Deeds Stamp & File Number

4.	Lot No, Recorded Plat
5.	Private Claims

MARK R. ROBISON NOVEMBER , in a field survey on do hereby certify that under requirements of P.A. 74, Michigan P.A. of 1970, the corner points mentioned in lines 1 and 2 above were in conformance with regulations and rules therefore as required in the current manual of survey instructions of the United States Department of the Interior, Bureau of Land Management or by a decree of a Court of Law and/or that the corner points mentioned in lines 3, 4 and 5 above were in conformance with the rules of the Michigan Board of Land Surveyors or by a Decree of a Court of Law; established, re-established, monumented, re-monumented, recovered, found as expressed below:

NOTE: Not more than 4 corners, all in the same town and range, may be recorded on this certificate.

Description of original monument and accessories and/or subsequent restoration: 1856 G.E. ADAIR, W. PINE 40" N 38-3/4°E, 47 LKS P. 359
W. PINE 28" S 56-1/2°W, 108 LKS
5-55 W.S. MOORE, STEEL POST S 05°E, 33.9' CSR 3-31/67
15" NORWAY S 40°W, 52.6'
30" OAK N 55°W, 46.0'
8-56 W.S. MOORE, CSR 3-52
10-2-72 LAPHAM, LCRC 52-72
3-7-73 COURTRIGHT, FOUND R.R. SPIKE LCRC 93-73

	A	В	С	D	E	F	G	Н	J	K	L	М
2		 6—	L,	 5 —	L.	4 —	L.	<b>3</b> —		Ĭ	[	
3	_	<u> </u>	<u>L</u>		_			L`				
4	_	 7—	L.	 8—	<u> </u>	9 —	_1		—1	1	1	2
5	L	ļ										
6		8—	L,	  7—	L,	6—	_,	 5	1	4	 1	3
7			_	Щ.	_	_				Щ		
8	L.	   <del>9</del> —	<u> </u> _2	! :0—	L_2	 !1—	2	  2	2	] 3	2	4
9		<u> </u>		L	L		┖					
10	L	 30	L_2	 !9—	2	 !8—	L_2	 !7	2	6	į	5
11	L			<u> </u>			L				Ш	
12	L.	] 31—	L.	  2—	L.	3	ļ <sub>3</sub>	4	<u>_</u> 3	  5	3	6—
13	L	1	<u> </u>	<u></u>								


Description of corner evidence found and/or method applied in restoring or reestablishing corner: FOUND R.R. SPIKE IN MON. BOX. EXCAVATED TO 32", FOUND 2" x 24" PIPE BELOW R.R. SPIKE & OVER 5/8" SOLID BAR. STOPPED BY SOLID OBJECT AT 32". COULD NOT PENETRATE WITH AUGER. FOUND REMAINS OF WOODEN STAKE WHEN EXCAVATING HOLE. FOUND RECORDED WITHESSES:

PIPE

N 50°W, 45.4' - 34" OAK S 45°E, 46.25' - 6" STL. PIF S 40°W, 52.6' - 15" NORWAY S 25°W, 36.0' - 6" STL. PIPI STL. PIPE

DROVE 5/8" x 36" RE-BAR THROUGH SOLID OBJECT AT 32" DEPTH

This Corner established in Clare County Remonumentation Program. See dossier for detailed report.

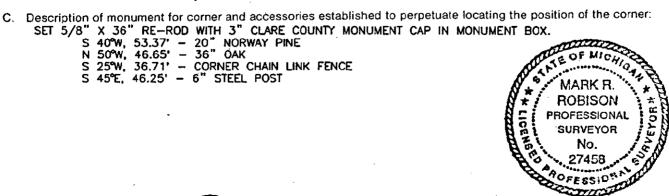

MARK

Surveyor's Michigan License No.

OF LAND SURVEYORS, JAN. 28, 1971 REVISED MAY 14, 1975